STRATA PLAN OF LOT 1, DISTRICT LOTS 151 AND 153, GP. 1, N.W.D., PLAN BCP3926

"CITY OF BURNABY"

B.C.G.S. 92G.025

STRATA PLAN BCS 1058

DEPOSITED AND REGISTERED IN THE LAND TITLE OFFICE AT NEW WESTMINSTER, B.C.

THIS 29 DAY OF NOV, 2004.

DEPUTY REGISTRAR Jan MacDonald

BW538837-996

"PRECIDIA"

4333 CENTRAL BOULEVARD, BURNABY, B.C.

SCALE 1:750

10 0 10 20 30

ALL DISTANCES ARE IN METRES.

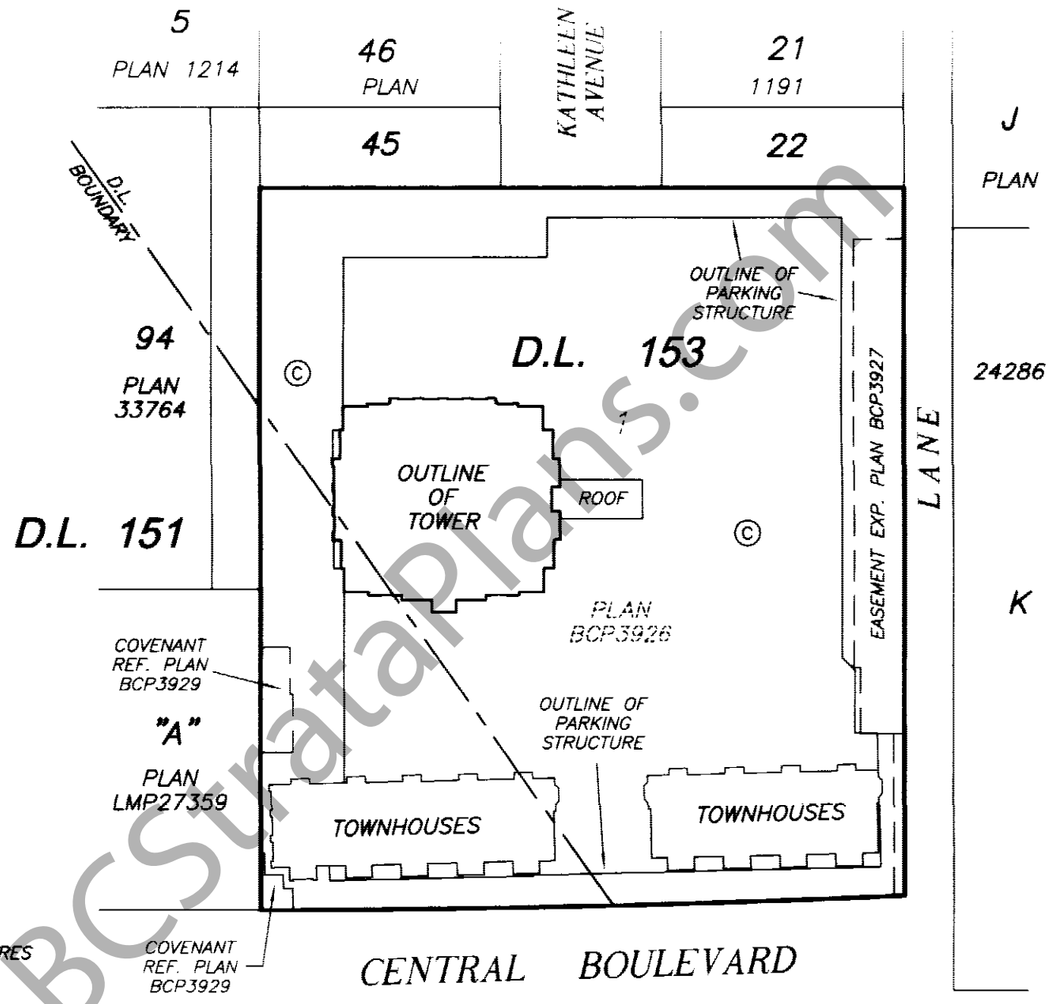

INTEGRATED SURVEY AREA No. 25 (BURNABY) NAD-83 (CSRS)

THIS PLAN SHOWS GROUND-LEVEL MEASURED DISTANCES. PRIOR TO COMPUTATION OF U.T.M. CO-ORDINATES, MULTIPLY BY COMBINED SCALE FACTOR 0.9995825

SEE SHEET 2 FOR PROPERTY DIMENSIONS

SEE SHEET 3 FOR BUILDING LOCATION AND DIMENSIONS

NOTE:

STRATA LOT BOUNDARIES ARE DEFINED AS CENTERLINE OF WALL FOR DEMISING WALLS OF STRATA LOTS AND 0.025 METRES (ONE INCH) INSIDE ALL EXTERIOR STRUCTURAL WALLS.

NOTE:

THIS PLAN DOES NOT HAVE A FOURTH OR THIRTEENTH FLOOR

THIS STRATA PLAN CONTAINS LIMITED COMMON PROPERTY ACCORDING TO SEC. 73 (a)(i) OF THE STRATA PROPERTY ACT.

LEGEND

GRID BEARINGS ARE DERIVED FROM OBSERVATIONS BETWEEN CONTROL MONUMENTS 87H3255 AND 87H3257

- ▲ – DENOTES CONTROL MONUMENT FOUND.
- ● – DENOTES STANDARD IRON POST FOUND.
- ■ – DENOTES LEAD PLUG FOUND.
- ○ – DENOTES STANDARD IRON POST PLACED.
- □ – DENOTES LEAD PLUG PLACED
- D/R – DENOTES DESTROYED/RESET
- SL. – DENOTES STRATA LOT.
- PT. – DENOTES PART.
- LCP – DENOTES LIMITED COMMON PROPERTY.
- (C) – DENOTES COMMON PROPERTY.
- (E) – DENOTES ELECTRICAL ROOM BEING COMMON PROPERTY.
- (V) – DENOTES VENT BEING COMMON PROPERTY.
- (MS) – DENOTES MECHANICAL SPACE BEING COMMON PROPERTY.
- (Y1) TYPICAL – DENOTES YARD BEING LIMITED COMMON PROPERTY FOR THE EXCLUSIVE USE OF SL. 1
- (B1) TYPICAL – DENOTES BALCONY BEING LIMITED COMMON PROPERTY FOR THE EXCLUSIVE USE OF SL. 1
- (P10) TYPICAL – DENOTES PATIO BEING LIMITED COMMON PROPERTY FOR THE EXCLUSIVE USE OF SL. 10
- (RD159) TYPICAL – DENOTES ROOF DECK BEING LIMITED COMMON PROPERTY FOR THE EXCLUSIVE USE OF SL. 159

I, MIKE E. SHAW, A BRITISH COLUMBIA LAND SURVEYOR CERTIFY THAT THE BUILDINGS SHOWN ON THIS STRATA PLAN ARE WITHIN THE THE EXTERNAL BOUNDARIES OF THE LAND THAT IS THE SUBJECT OF THE STRATA PLAN.

DATE: NOVEMBER 25, 2004.

Mike E Shaw

BENNETT & ASSOCIATES
B.C. LAND SURVEYORS
#201-9547 152nd STREET,
SURREY, B.C.
PHONE : 582-0717

DRAWING # 30412-20
FILE # 30412-20_FS
DATE : NOVEMBER 25, 2004.

THIS PLAN LIES WITHIN THE GREATER VANCOUVER REGIONAL DISTRICT

ORIGINAL

www.BCStrataPlans.com

FILED NWBCS1058 T91981 2006-05-17-13.09.44.606497

PROPERTY DIMENSIONS

STRATA PLAN BCS 1058

SCALE 1:750

10 0 10 20 30

ALL DISTANCES ARE IN METRES.

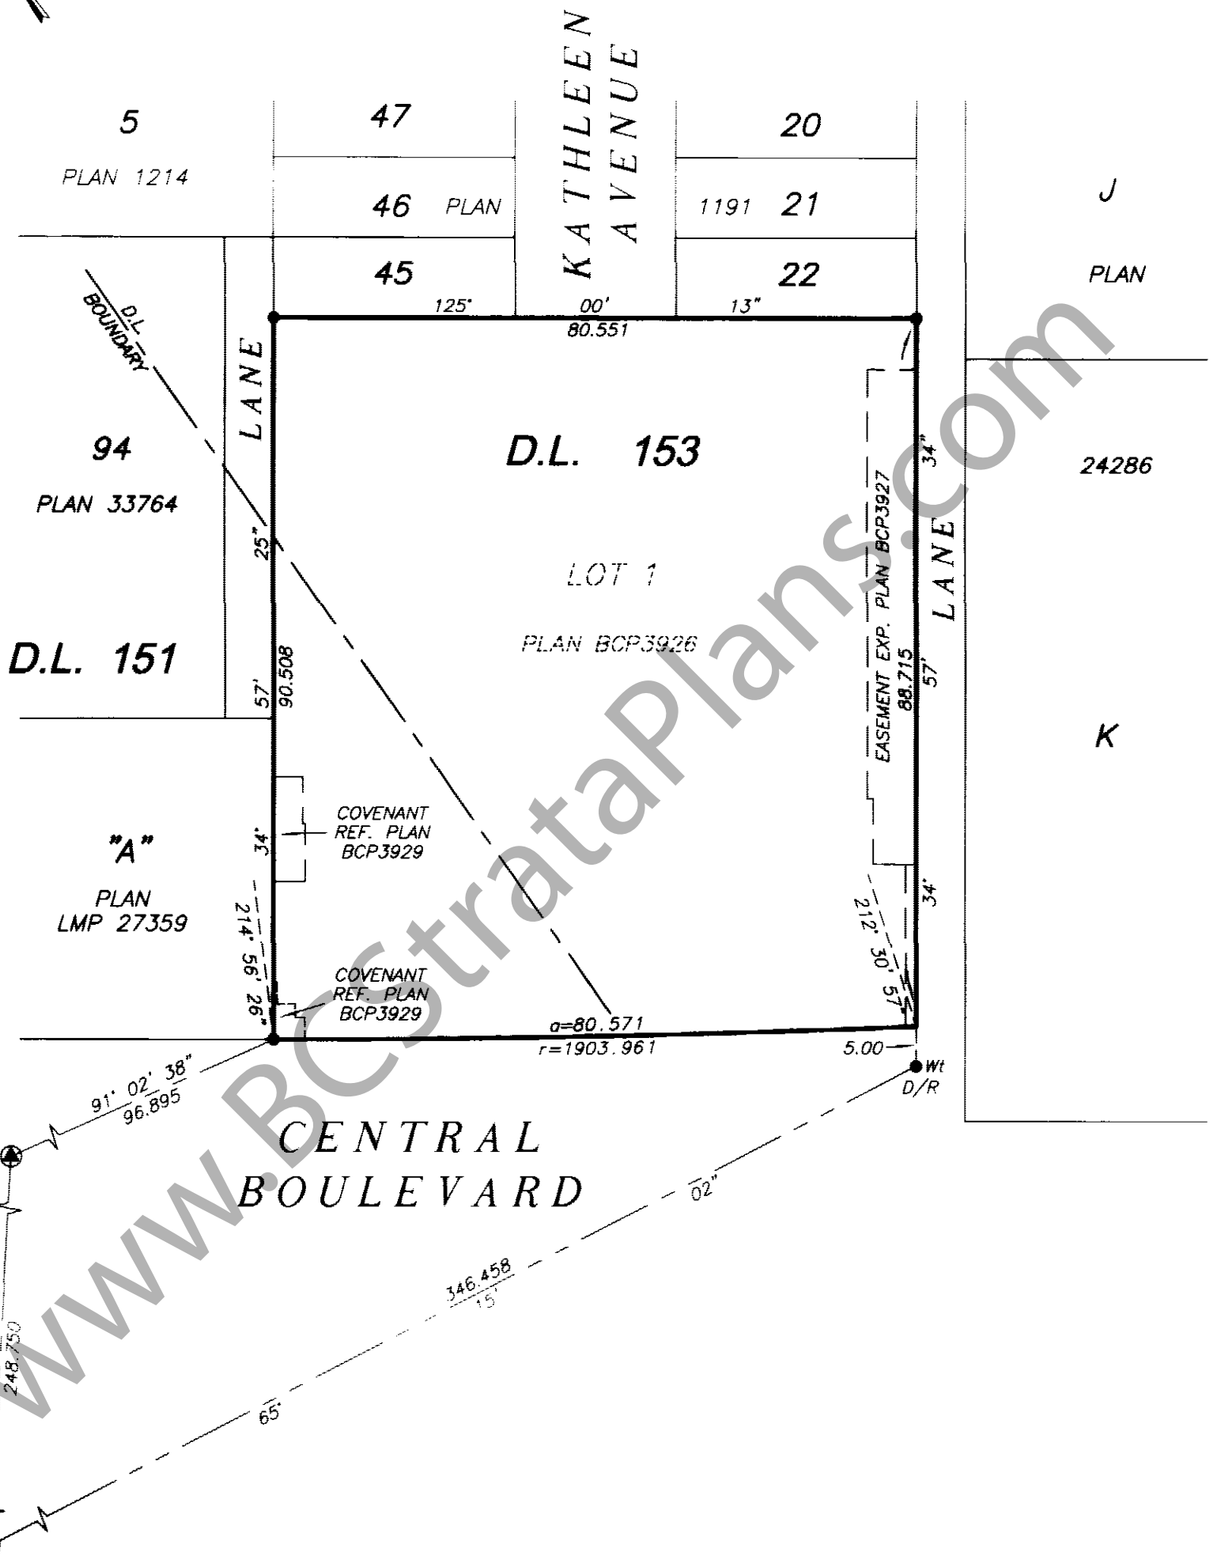

I, MIKE E. SHAW, A BRITISH COLUMBIA LAND SURVEYOR, OF LANGLEY, IN BRITISH COLUMBIA, CERTIFY THAT I WAS PRESENT AT AND PERSONALLY SUPERINTENDED THE SURVEY REPRESENTED BY THIS PLAN, AND THAT THE SURVEY AND PLAN ARE CORRECT. THE SURVEY WAS COMPLETED ON THE 25th DAY OF NOVEMBER, 2004. THE PLAN WAS COMPLETED AND CHECKED, AND THE CHECKLIST FILED UNDER # ECP24332, 25th DAY OF NOVEMBER, 2004.

Mike E Shaw B.C.L.S.

DATE : NOVEMBER 25, 2004.

M.E.S.

DRAWING # 30412-20
FILE # 30412-20_Post

ORIGINAL

www.BCstrataPlans.com

FILED NWBCS1058 T91981 2006-05-17-13.09.44.606497

BUILDING LOCATION AND DIMENSIONS

STRATA PLAN BCS 1058

SCALE 1:500

10 0 10 20

ALL DISTANCES ARE IN METRES.

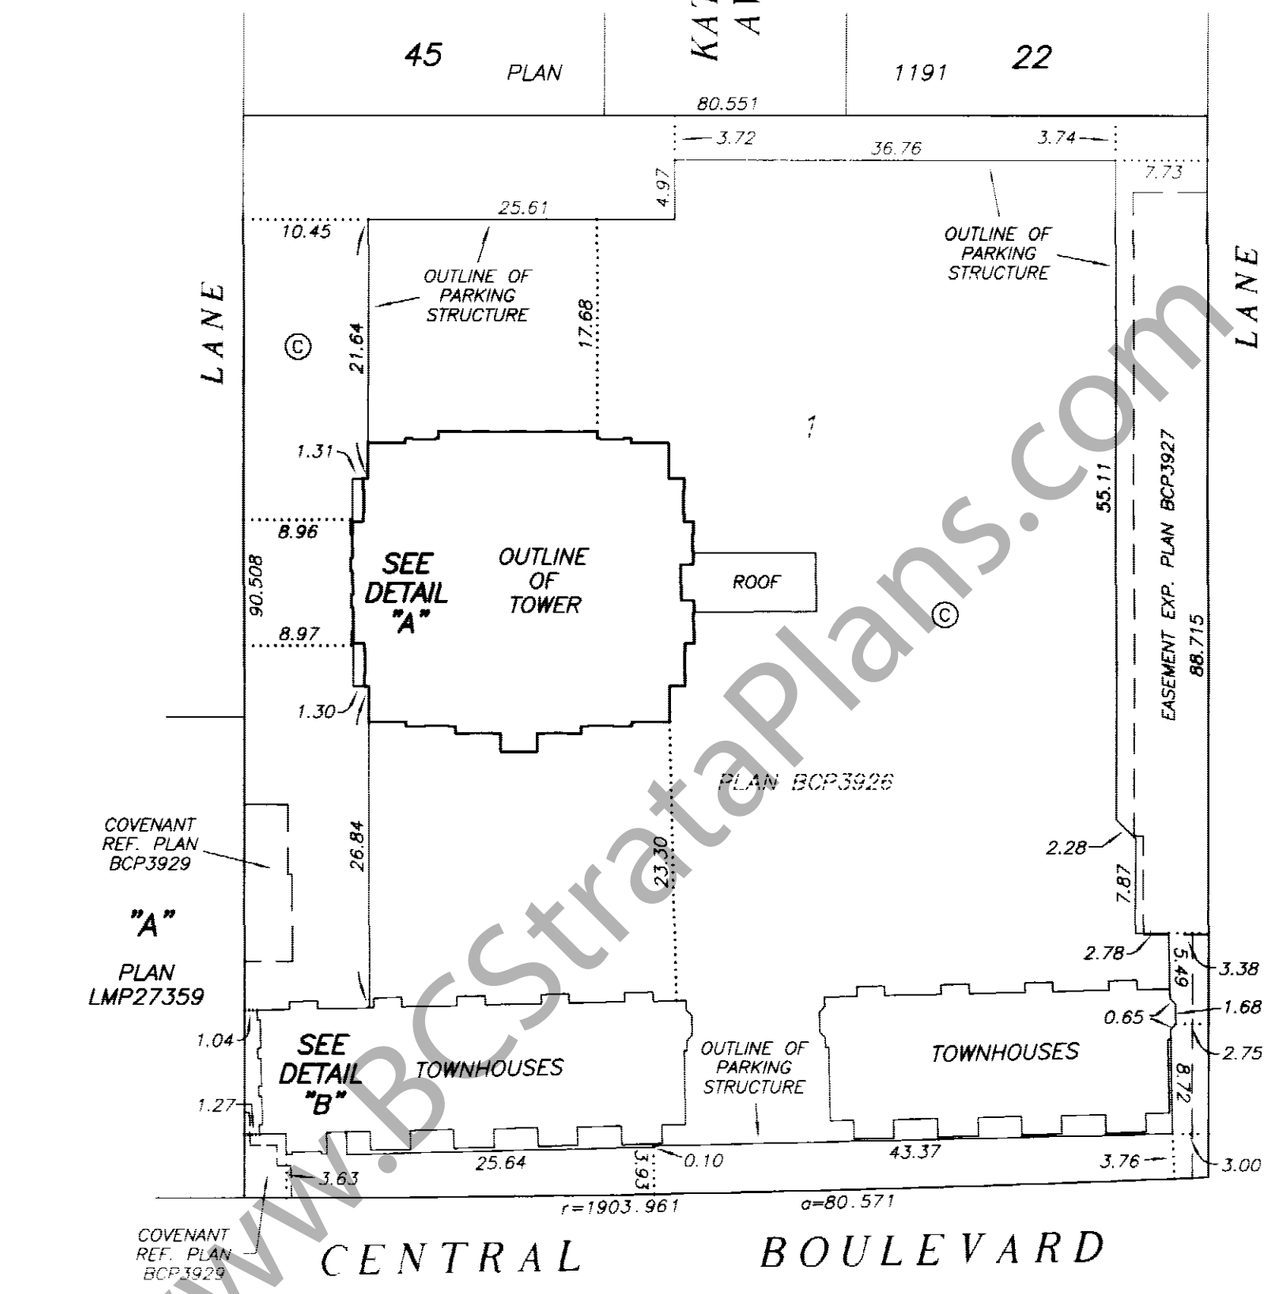

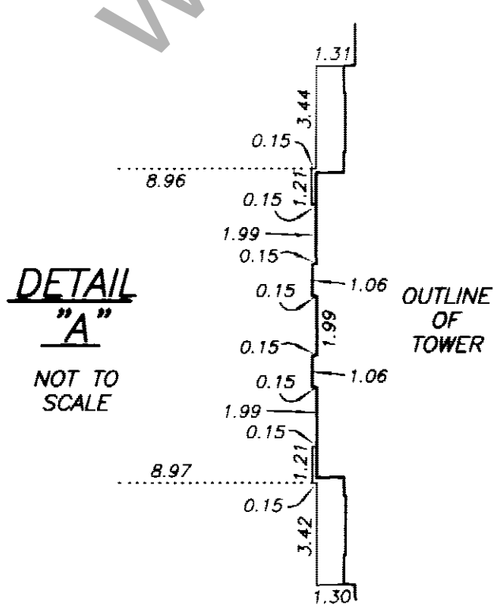

DETAIL "A"

NOT TO SCALE

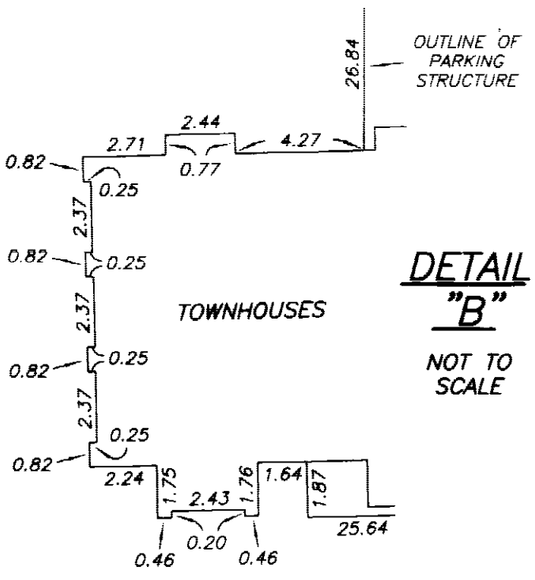

DETAIL "B"

NOT TO SCALE

DATE : NOVEMBER 25, 2004.

M.E.B.

DRAWING # 30412-20
FILE # 30412-20_CE

ORIGINAL

www.BCStrataPlans.com

FILED NWBCS1058 T91981 2006-05-17-13.09.44.606497

STRATA PLAN BCS 1058

OWNER :

BOSA VENTURES (BURNABY) INC.
(INC. NO. 608840)

AUTHORIZED SIGNATORY COLIN BOSA

~~AUTHORIZED SIGNATORY~~

WITNESS AS TO ~~BOTH~~ SIGNATURES
DIRK C.A. DE VVIET

SOLICITOR
OCCUPATION OF WITNESS
1201-4565 KINGSWAY
BURNABY, B.C. V5H 4T8
ADDRESS OF WITNESS

MORTGAGEE :

MCAP FINANCIAL CORPORATION
(INCORPORATION No. A50930)

AUTHORIZED SIGNATORY
BOB MACIVER

~~AUTHORIZED SIGNATORY~~

WITNESS AS TO ~~BOTH~~ SIGNATURES
DIRK C.A. DE VVIET

SOLICITOR
OCCUPATION OF WITNESS
1201-4565 KINGSWAY
BURNABY, B.C. V5H 4T8
ADDRESS OF WITNESS

I, MIKE E. SHAW, A BRITISH COLUMBIA LAND SURVEYOR, CERTIFY THAT THE BUILDING INCLUDED IN THIS STRATA PLAN HAS NOT, AS OF NOVEMBER 25th , 2004, BEEN PREVIOUSLY OCCUPIED.

Mike E Shaw B.C.L.S.

THE CITY OF BURNABY, REGISTERED OWNER OF COVENANTS BV71589, BV71590 AND BV71591, HEREBY CONSENTS TO THE DEPOSIT OF THIS PLAN.

DEBBIE R. COMIS
City Clerk

AUTHORIZED SIGNATORY

AUTHORIZED SIGNATORY

DRAWING # 30412-20
FILE # 30412-20_Sig

DATE : NOVEMBER 25, 2004.

M.E.S.

ORIGINAL

www.BCStrataPlans.com

FILED NWBCS1058 T91981 2006-05-17-13.09.44.606497

FILED NWBCS1058 T91981 2006-05-17-13.09.44.606497

EAST TOWNHOUSES
SECTION A – A'

STRATA PLAN BCS 1058

SCALE 1:125

2 0 2 4 6

ALL DISTANCES ARE IN METRES.

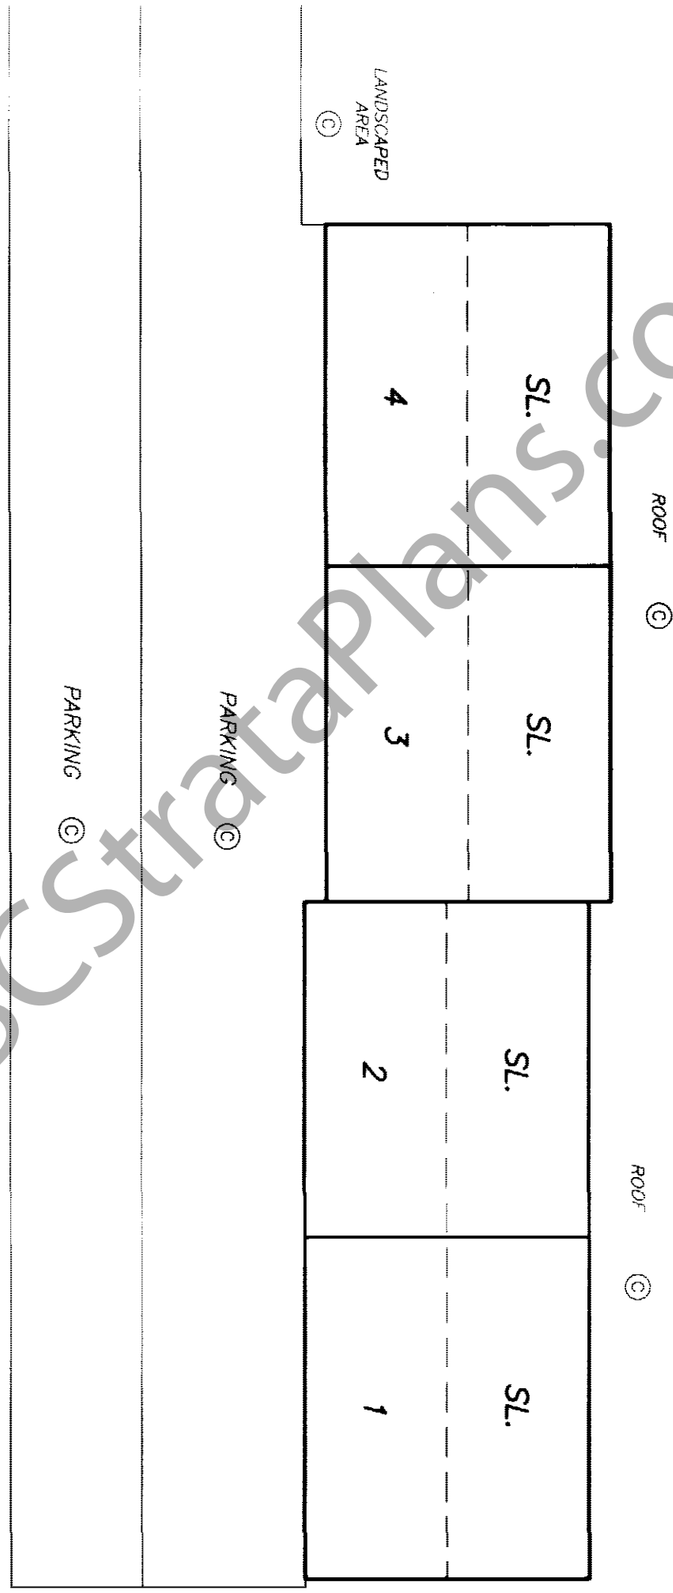

www.BCStrataPlans.com

DATE : NOVEMBER 25, 2004.

M.E.S.

DRAWING # 30412-20
FILE # 30412-20-TH

ORIGINAL

ORIGINAL

DRAWING # 30412-20
FILE # 30412-20-TH

DATE : NOVEMBER 25, 2004.

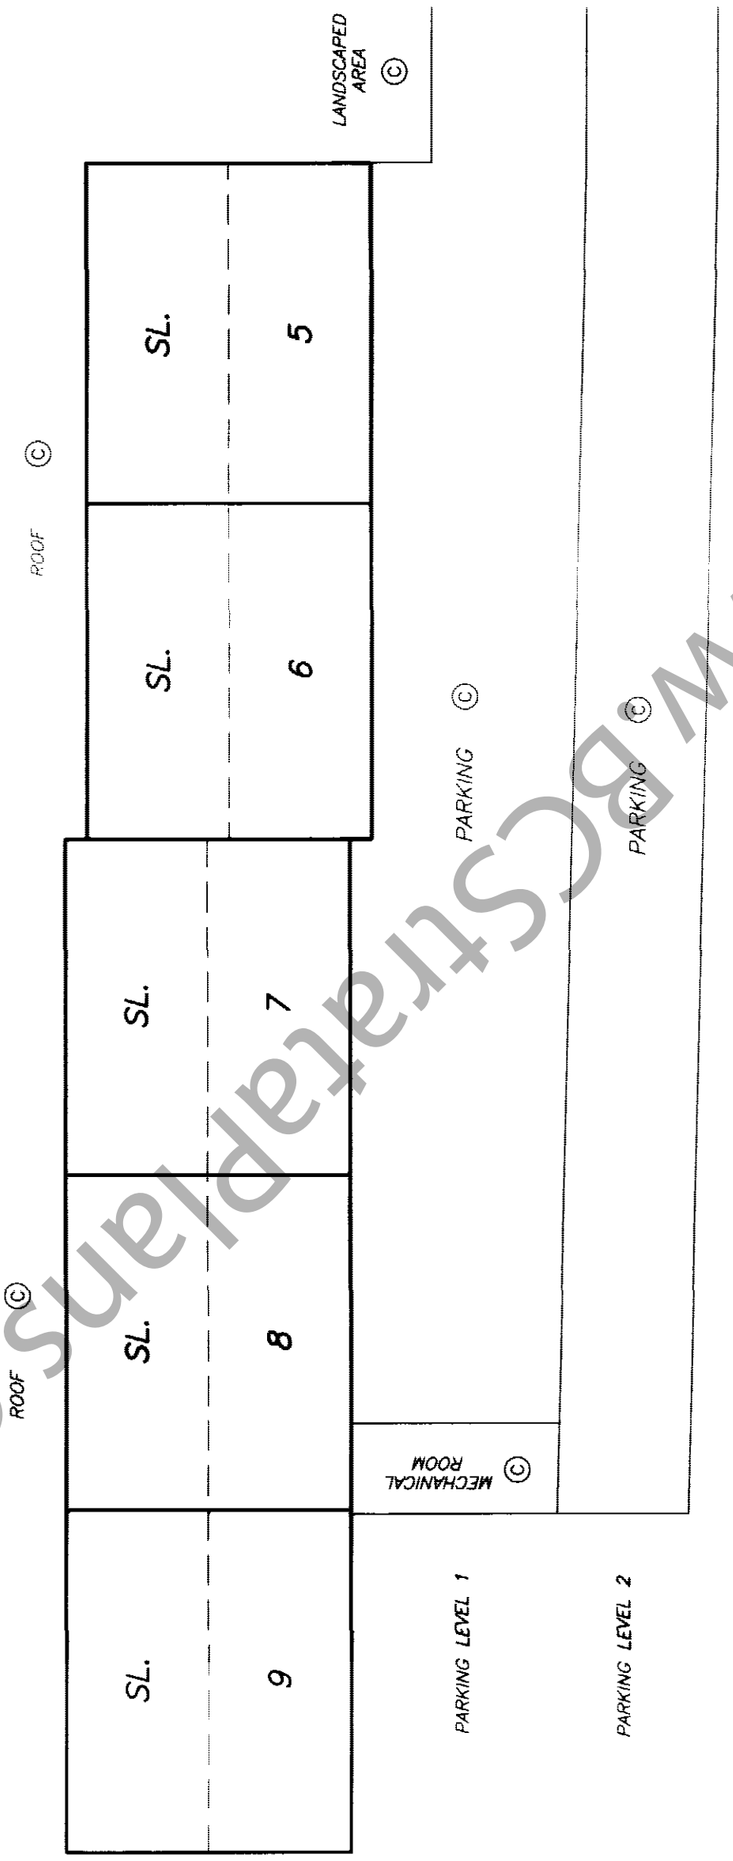

ALL DISTANCES ARE IN METRES.

SCALE 1:125

WEST TOWNHOUSES
SECTION B - B'

STRATA PLAN BCS 1058

SHEET 6 OF 47 SHEETS

www.bcstrataplans.com

FILED NWBCS1058 T91981 2006-05-17-13.09.44.606497

SECTION C – C'

STRATA PLAN BCS 1058

SCALE 1:150

2 0 2 4 6

ALL DISTANCES ARE IN METRES.

SEE SHEET #8
FOR CONTINUATION

SL. 84	SL. 85	SL. 86	LEVEL 17
SL. 79	SL. 80	SL. 81	LEVEL 16
SL. 74	SL. 75	SL. 76	LEVEL 15
SL. 69	SL. 70	SL. 71	LEVEL 14
SL. 64	SL. 65	SL. 66	LEVEL 12
SL. 59	SL. 60	SL. 61	LEVEL 11
SL. 54	SL. 55	SL. 56	LEVEL 10
SL. 48	SL. 49	SL. 50	LEVEL 9
SL. 42	SL. 43	SL. 44	LEVEL 8
SL. 36	SL. 37	SL. 38	LEVEL 7
SL. 30	SL. 31	SL. 32	LEVEL 6
SL. 24	SL. 25	SL. 26	LEVEL 5
SL. 18	SL. 19	SL. 20	LEVEL 3
SL. 12	SL. 13	SL. 14	LEVEL 2
SL. 10	SL. 11	CORRIDOR © · CHANGE ROOM © · STORAGE © · SPA ©	MAIN LEVEL
		LANDSCAPED AREA ©	
P10			
PARKING ©	LOCKERS ©	STAIRS © · LOCKERS © · SPA EQUIPMENT ROOM © · PARKING ©	PARKING LEVEL 1
PARKING ©	LOCKERS ©	ELECTRICAL ROOM © · PARKING ©	PARKING LEVEL 2

DATE : NOVEMBER 25, 2004.

M.E.K.

DRAWING # 30412-20
FILE # 30412-20_SecC

ORIGINAL

www.BCStrataPlans.com

FILED NMBCS1058 T91981 2006-05-17-13.09.44.606497

SECTION C – C'

STRATA PLAN BCS 1058

SCALE 1:150

2 0 2 4 6

ALL DISTANCES ARE IN METRES.

	ROOF TERRACE Ⓒ		MECHANICAL LEVEL
RD159	SL. 159	RD159	LEVEL 32
SL. 154	SL. 155	SL. 156	LEVEL 31
SL. 149	SL. 150	SL. 151	LEVEL 30
SL. 144	SL. 145	SL. 146	LEVEL 29
SL. 139	SL. 140	SL. 141	LEVEL 28
SL. 134	SL. 135	SL. 136	LEVEL 27
SL. 129	SL. 130	SL. 131	LEVEL 26
SL. 124	SL. 125	SL. 126	LEVEL 25
SL. 119	SL. 120	SL. 121	LEVEL 24
SL. 114	SL. 115	SL. 116	LEVEL 23
SL. 109	SL. 110	SL. 111	LEVEL 22
SL. 104	SL. 105	SL. 106	LEVEL 21
SL. 99	SL. 100	SL. 101	LEVEL 20
SL. 94	SL. 95	SL. 96	LEVEL 19
SL. 89	SL. 90	SL. 91	LEVEL 18
SL. 84	SL. 85	SL. 86	LEVEL 17
SL. 79	SL. 80	SL. 81	LEVEL 16

SEE SHEET #7
FOR CONTINUATION

DATE : NOVEMBER 25, 2004.

DRAWING # 30412-20
FILE # 30412-20_SecC

ORIGINAL

www.BCStrataPlans.com

FILED NMBCS1058 T91981 2006-05-17-13.09.44.606497

SECTION D – D'

STRATA PLAN BCS 1058

SCALE 1:150

2 0 2 4 6

ALL DISTANCES ARE IN METRES.

SEE SHEET #10
FOR CONTINUATION

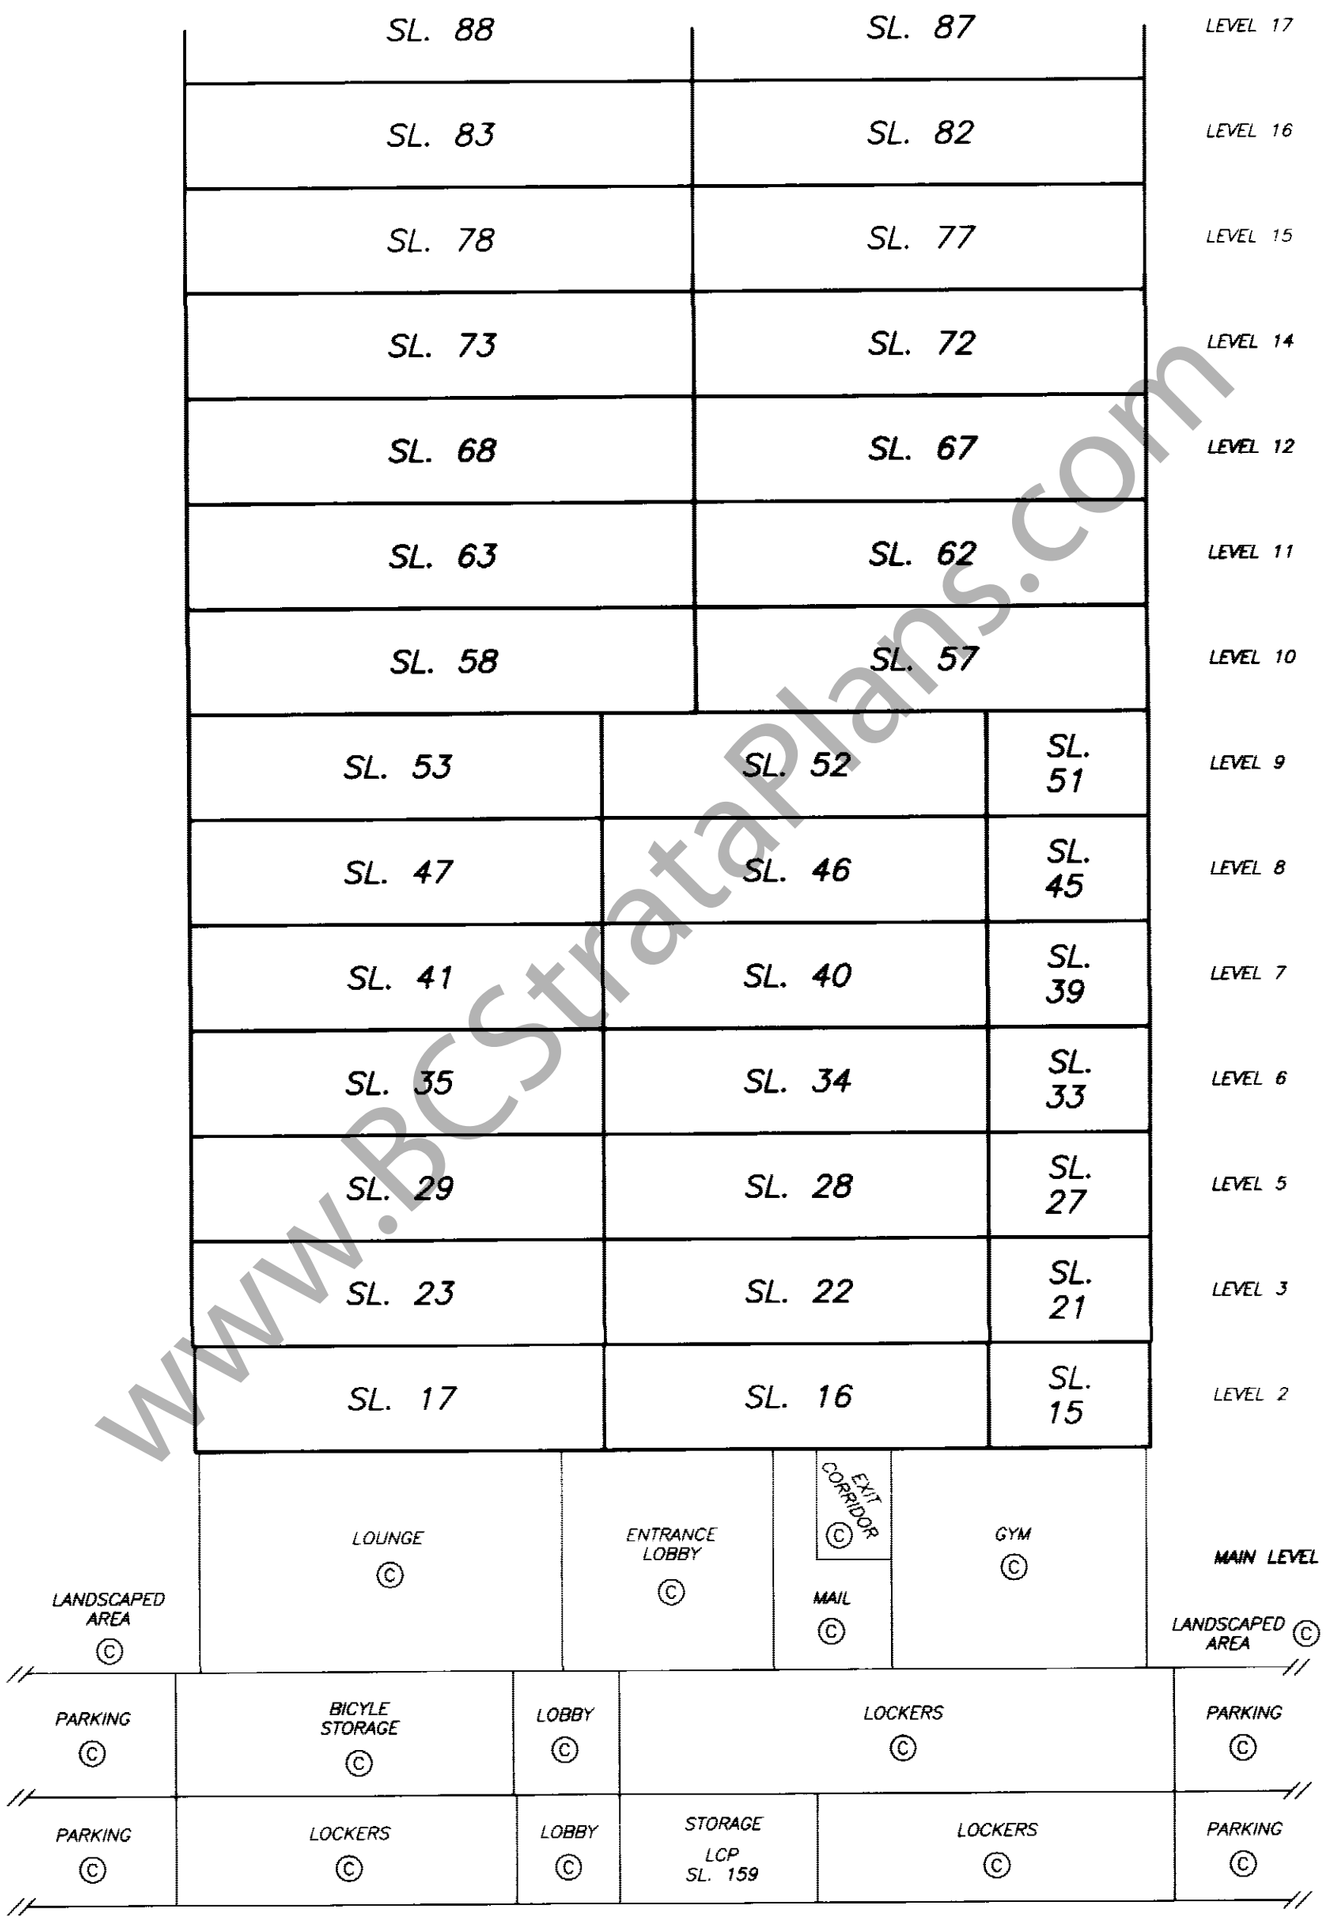

DATE : NOVEMBER 25, 2004.

M. E. B.

DRAWING # 30412-20
FILE # 30412-20_SecD

ORIGINAL

www.BCStrataPlans.com

FILED NMBCS1058 T91981 2006-05-17-13.09.44.606497

SECTION D – D'

STRATA PLAN BCS 1058

SCALE 1:150

2 0 2 4 6

ALL DISTANCES ARE IN METRES.

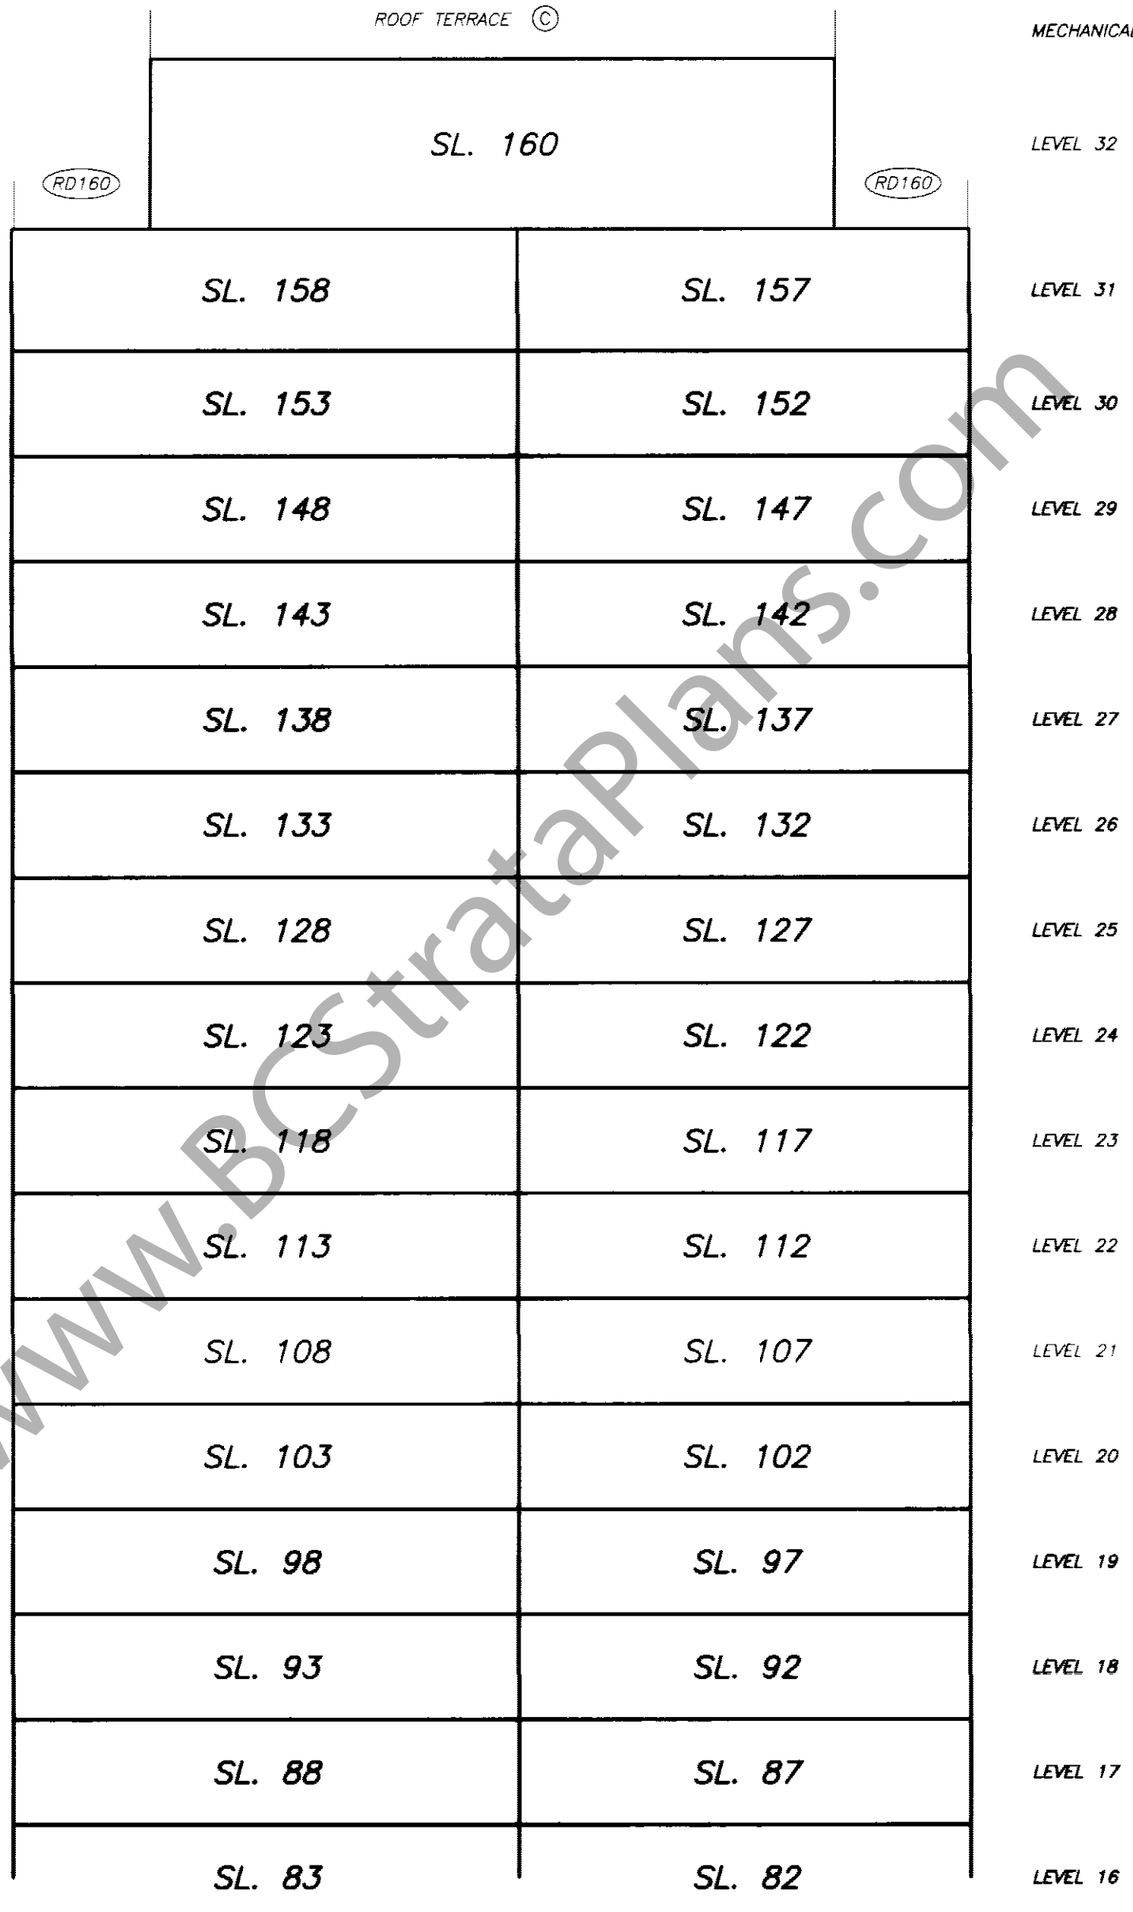

SEE SHEET #9
FOR CONTINUATION

DATE : NOVEMBER 25, 2004.

DRAWING # 30412-20
FILE # 30412-20_SecD

ORIGINAL

www.BCStrataPlans.com

FILED NWBCS1058 T91981 2006-05-17-13.09.44.606497

PARKING LEVEL 2

STRATA PLAN BCS 1058

SCALE 1:400

5 0 5 10 15

ALL DISTANCES ARE IN METRES.

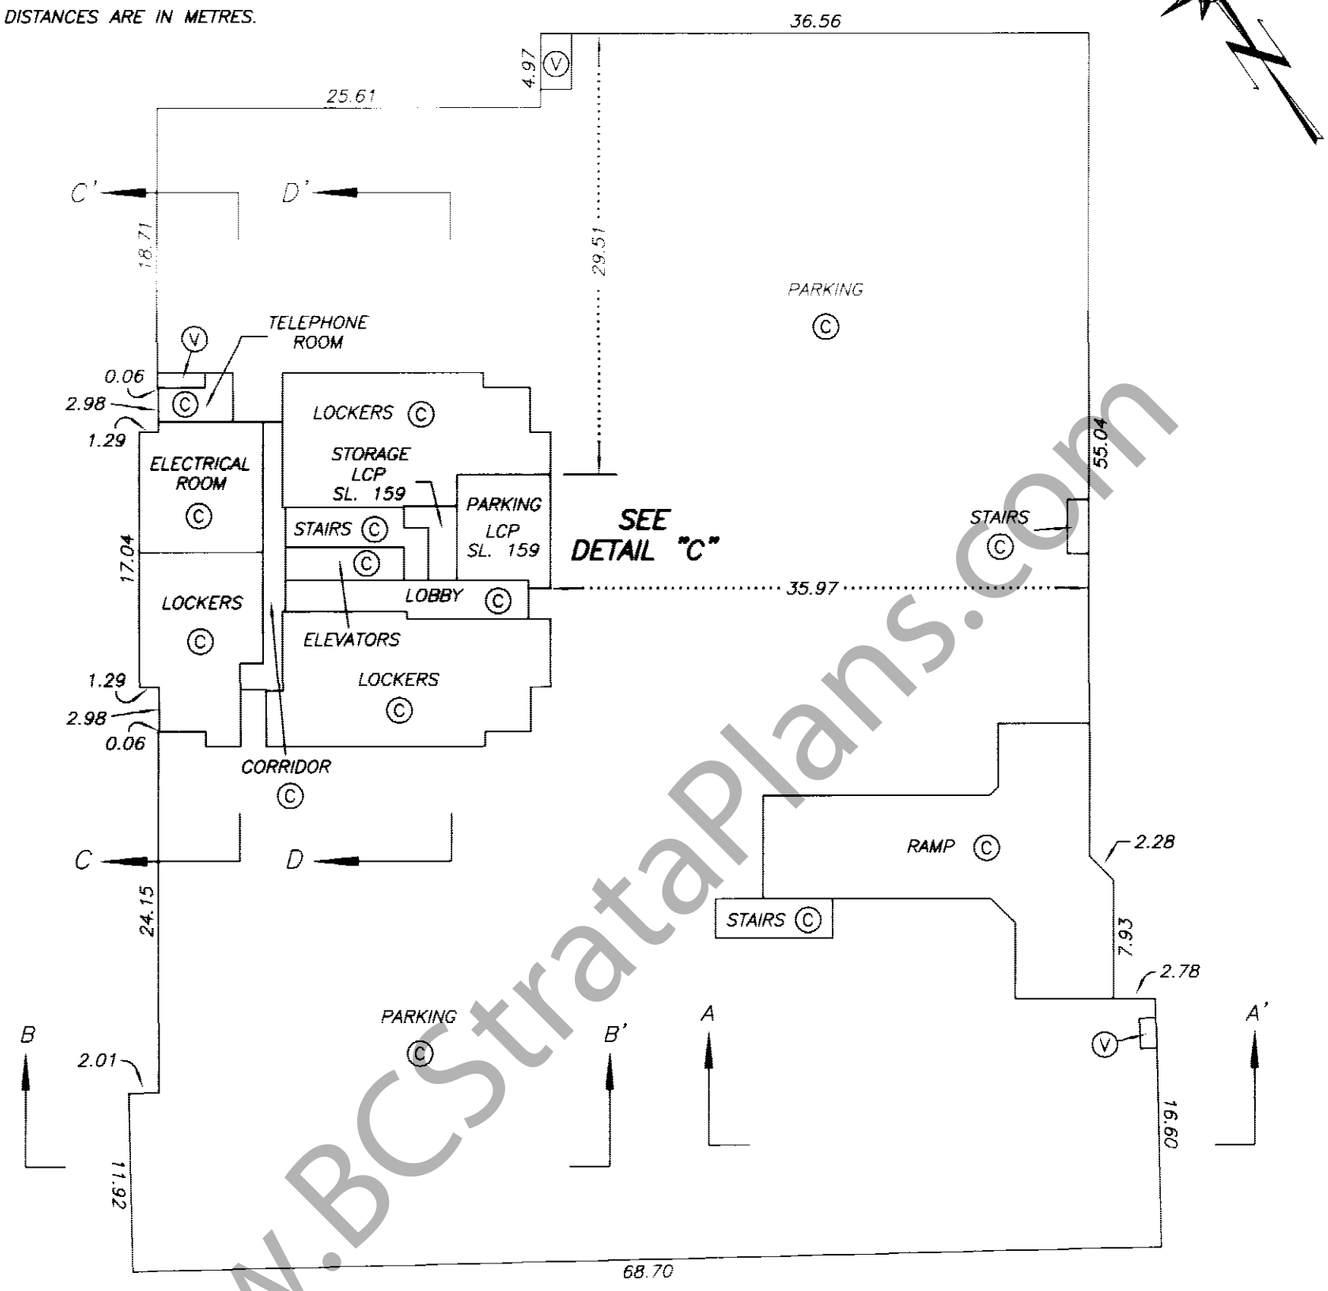

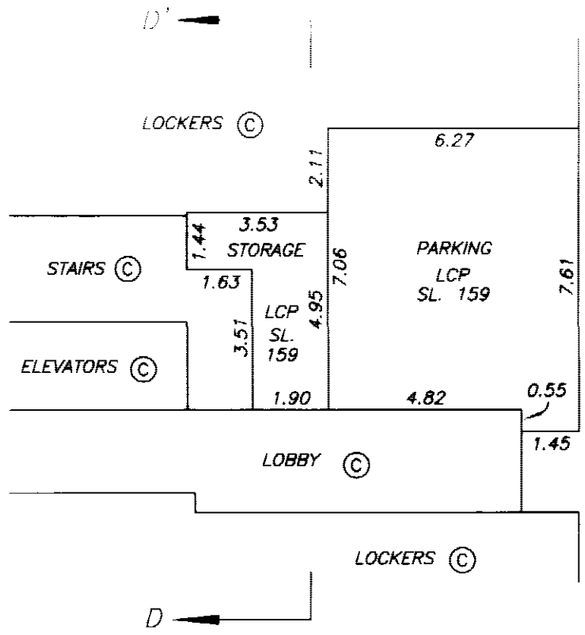

DETAIL "C"

NOT TO SCALE

DRAWING # 30412-20
FILE # 30412-20_P2

DATE : NOVEMBER 25, 2004.

M.E.B.

ORIGINAL

www.BCStrataPlans.com

FILED NMBCS1058 T91981 2006-05-17-13.09.44.606497

PARKING LEVEL 1

STRATA PLAN BCS 1058

SCALE 1:400

5 0 5 10 15

ALL DISTANCES ARE IN METRES.

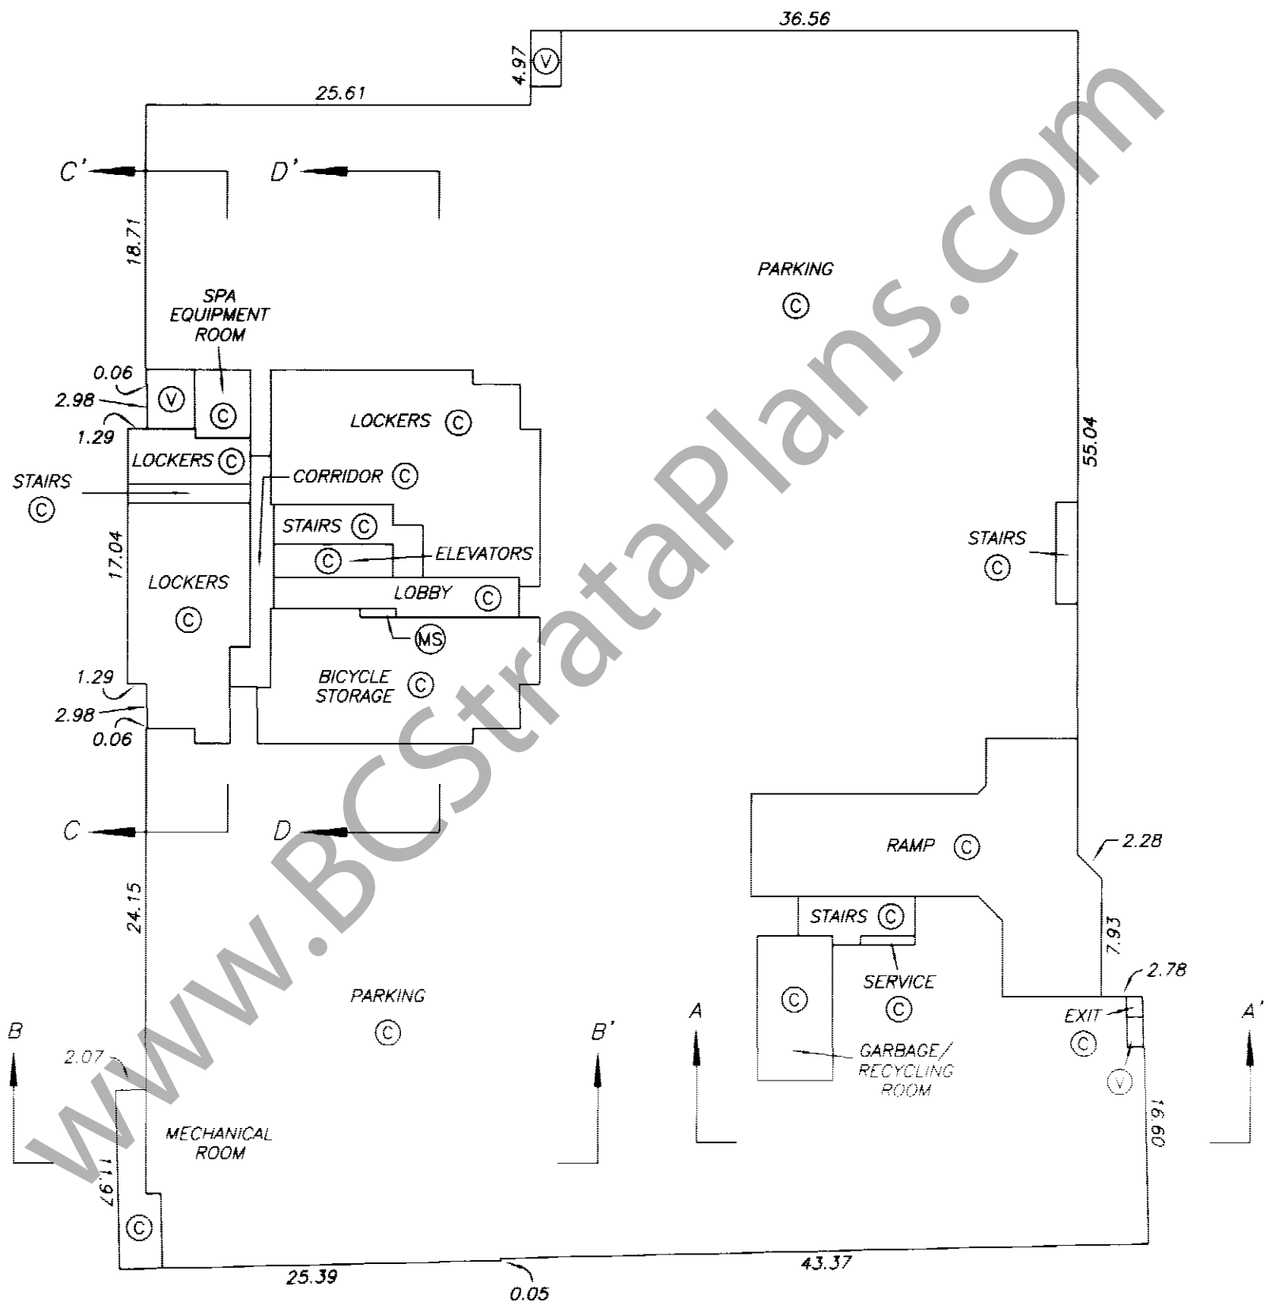

www.BCStrataPlans.com

DRAWING # 30412-20
FILE # 30412-20_P1

DATE : NOVEMBER 25, 2004.

M.E.S.

ORIGINAL

FILED NMBCS1058 T91981 2006-05-17-13.09.44.606497

EAST TOWNHOUSES
LEVEL 1 FLOOR PLAN

STRATA PLAN BCS 1058

SCALE 1:125

2 0 2 4 6

ALL DISTANCES ARE IN METRES.

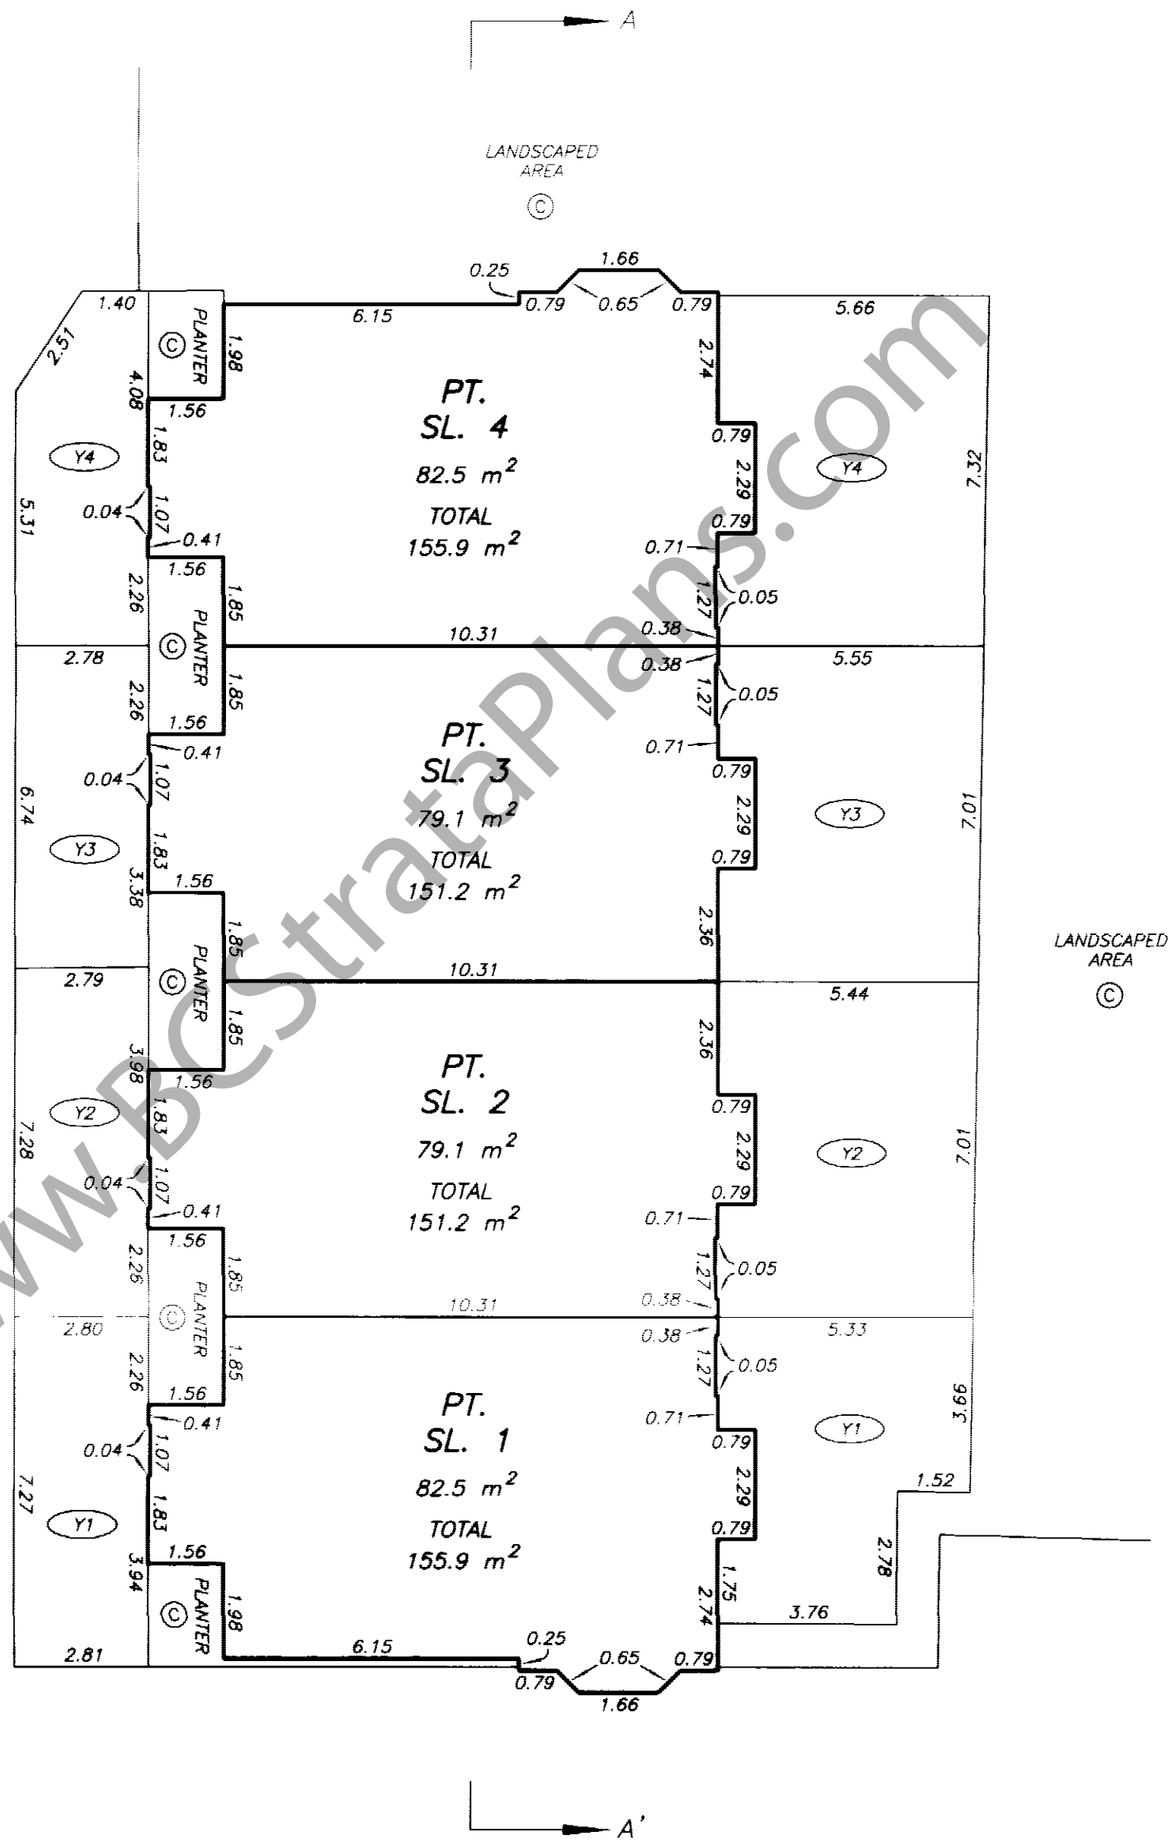

NOTE : ALL STRATA LOT BOUNDARIES ARE PARALLEL, PERPENDICULAR, OR AT A 45° DEFLECTION UNLESS OTHERWISE SHOWN

DATE : NOVEMBER 25, 2004.

M.E.B.

DRAWING # 30412-20
FILE # 30412-20_TH

ORIGINAL

www.BCStrataPlans.com

FILED NMBCS1058 T91981 2006-05-17-13.09.44.606497

EAST TOWNHOUSES
LEVEL 2 FLOOR PLAN

STRATA PLAN BCS 1058

SCALE 1:125

2 0 2 4 6

ALL DISTANCES ARE IN METRES.

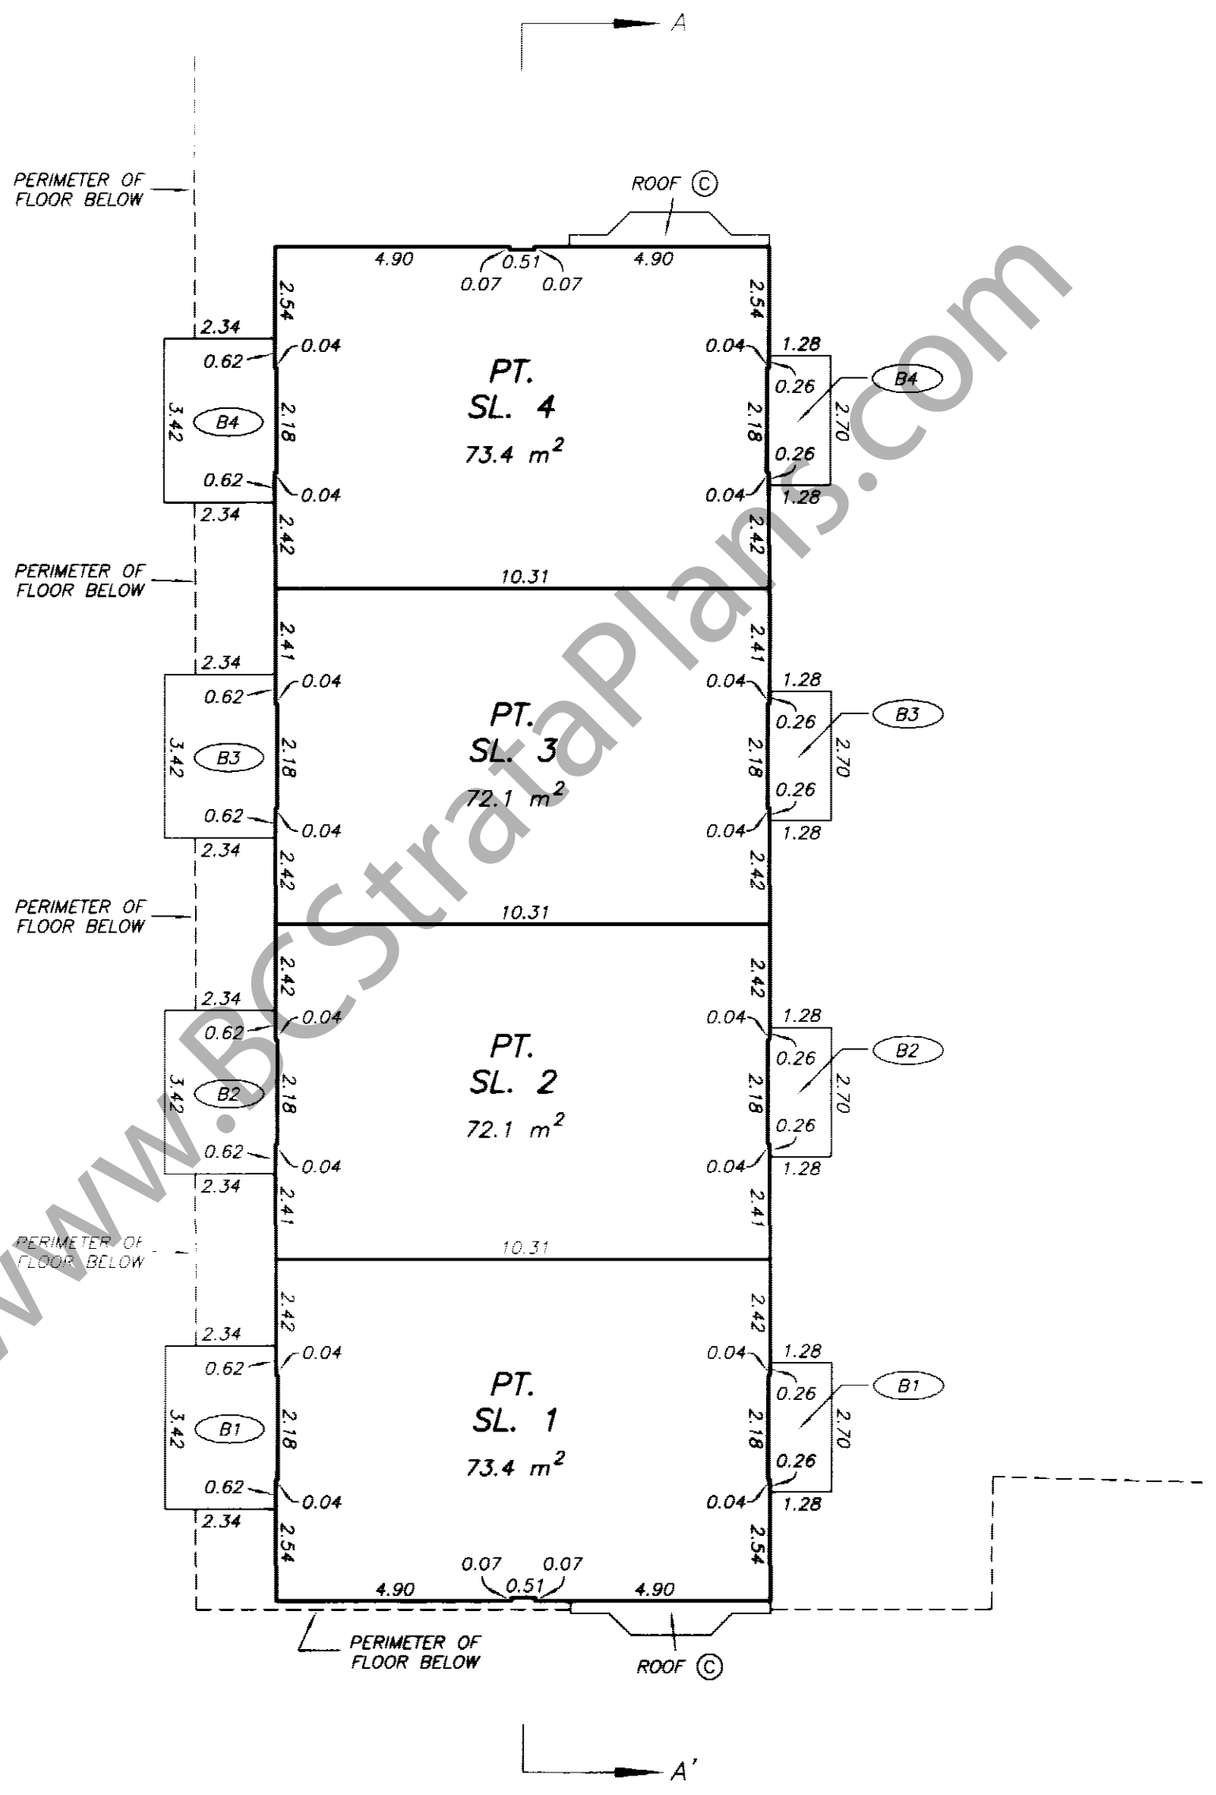

www.BCStrataPlans.com

DRAWING # 30412-20
FILE # 30412-20-TH

DATE : NOVEMBER 25, 2004.

M.E.S.

ORIGINAL

FILED NMBCS1058 T91981 2006-05-17-13.09.44.606497

WEST TOWNHOUSES
LEVEL 1 FLOOR PLAN

STRATA PLAN BCS 1058

SCALE 1:125

2 0 2 4 6

ALL DISTANCES ARE IN METRES.

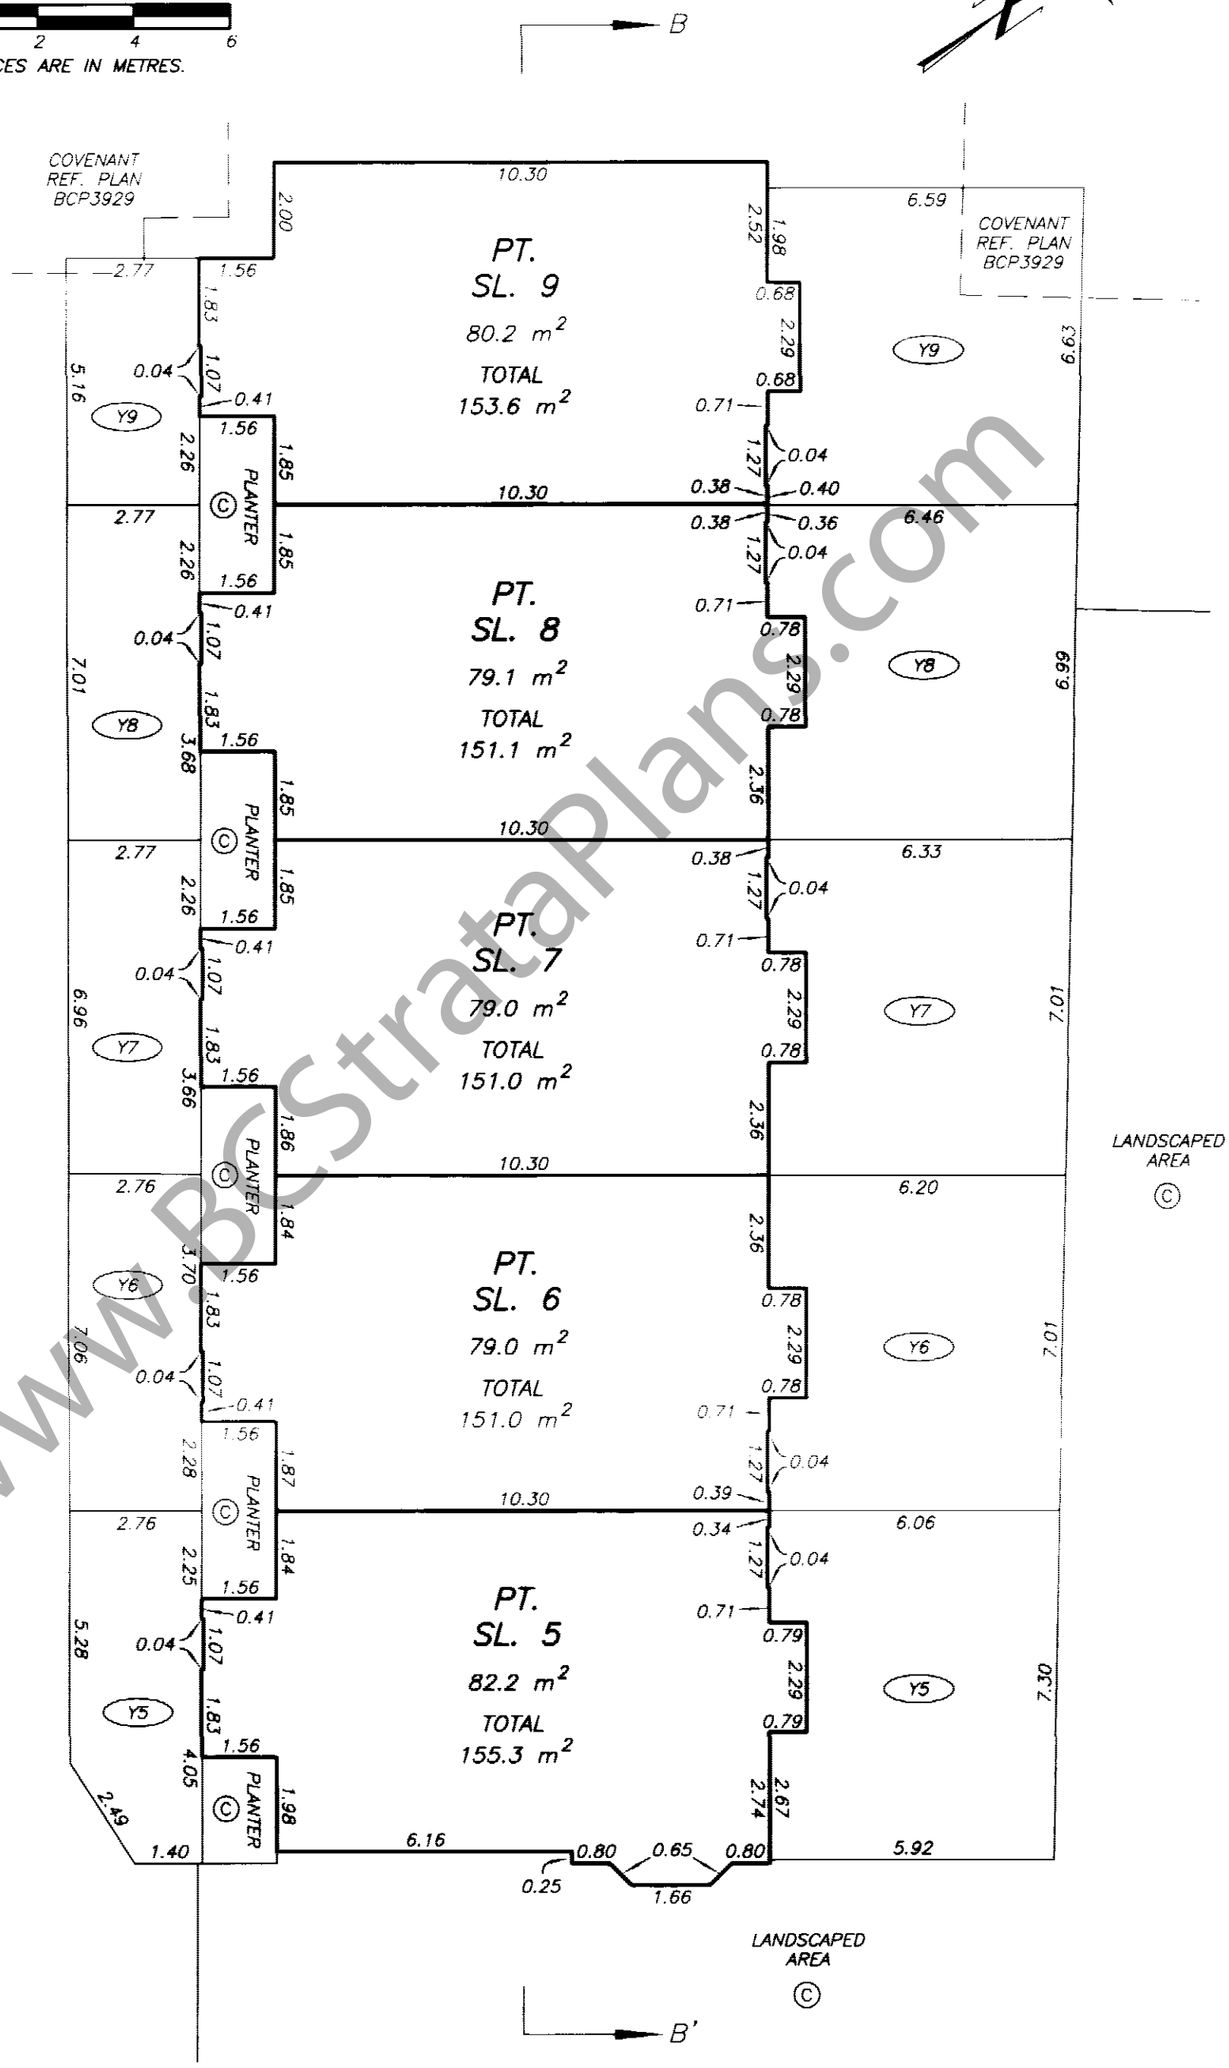

www.BCStrataPlans.com

NOTE : ALL STRATA LOT BOUNDARIES ARE PARALLEL, PERPENDICULAR, OR AT A 45° DEFLECTION UNLESS OTHERWISE SHOWN

DATE : NOVEMBER 25, 2004.

M.E.B.

DRAWING # 30412-20
FILE # 30412-20_TH

ORIGINAL

FILED NMBCS1058 T91981 2006-05-17-13.09.44.606497

WEST TOWNHOUSES
LEVEL 2 FLOOR PLAN

STRATA PLAN BCS 1058

SCALE 1:125

2 0 2 4 6

ALL DISTANCES ARE IN METRES.

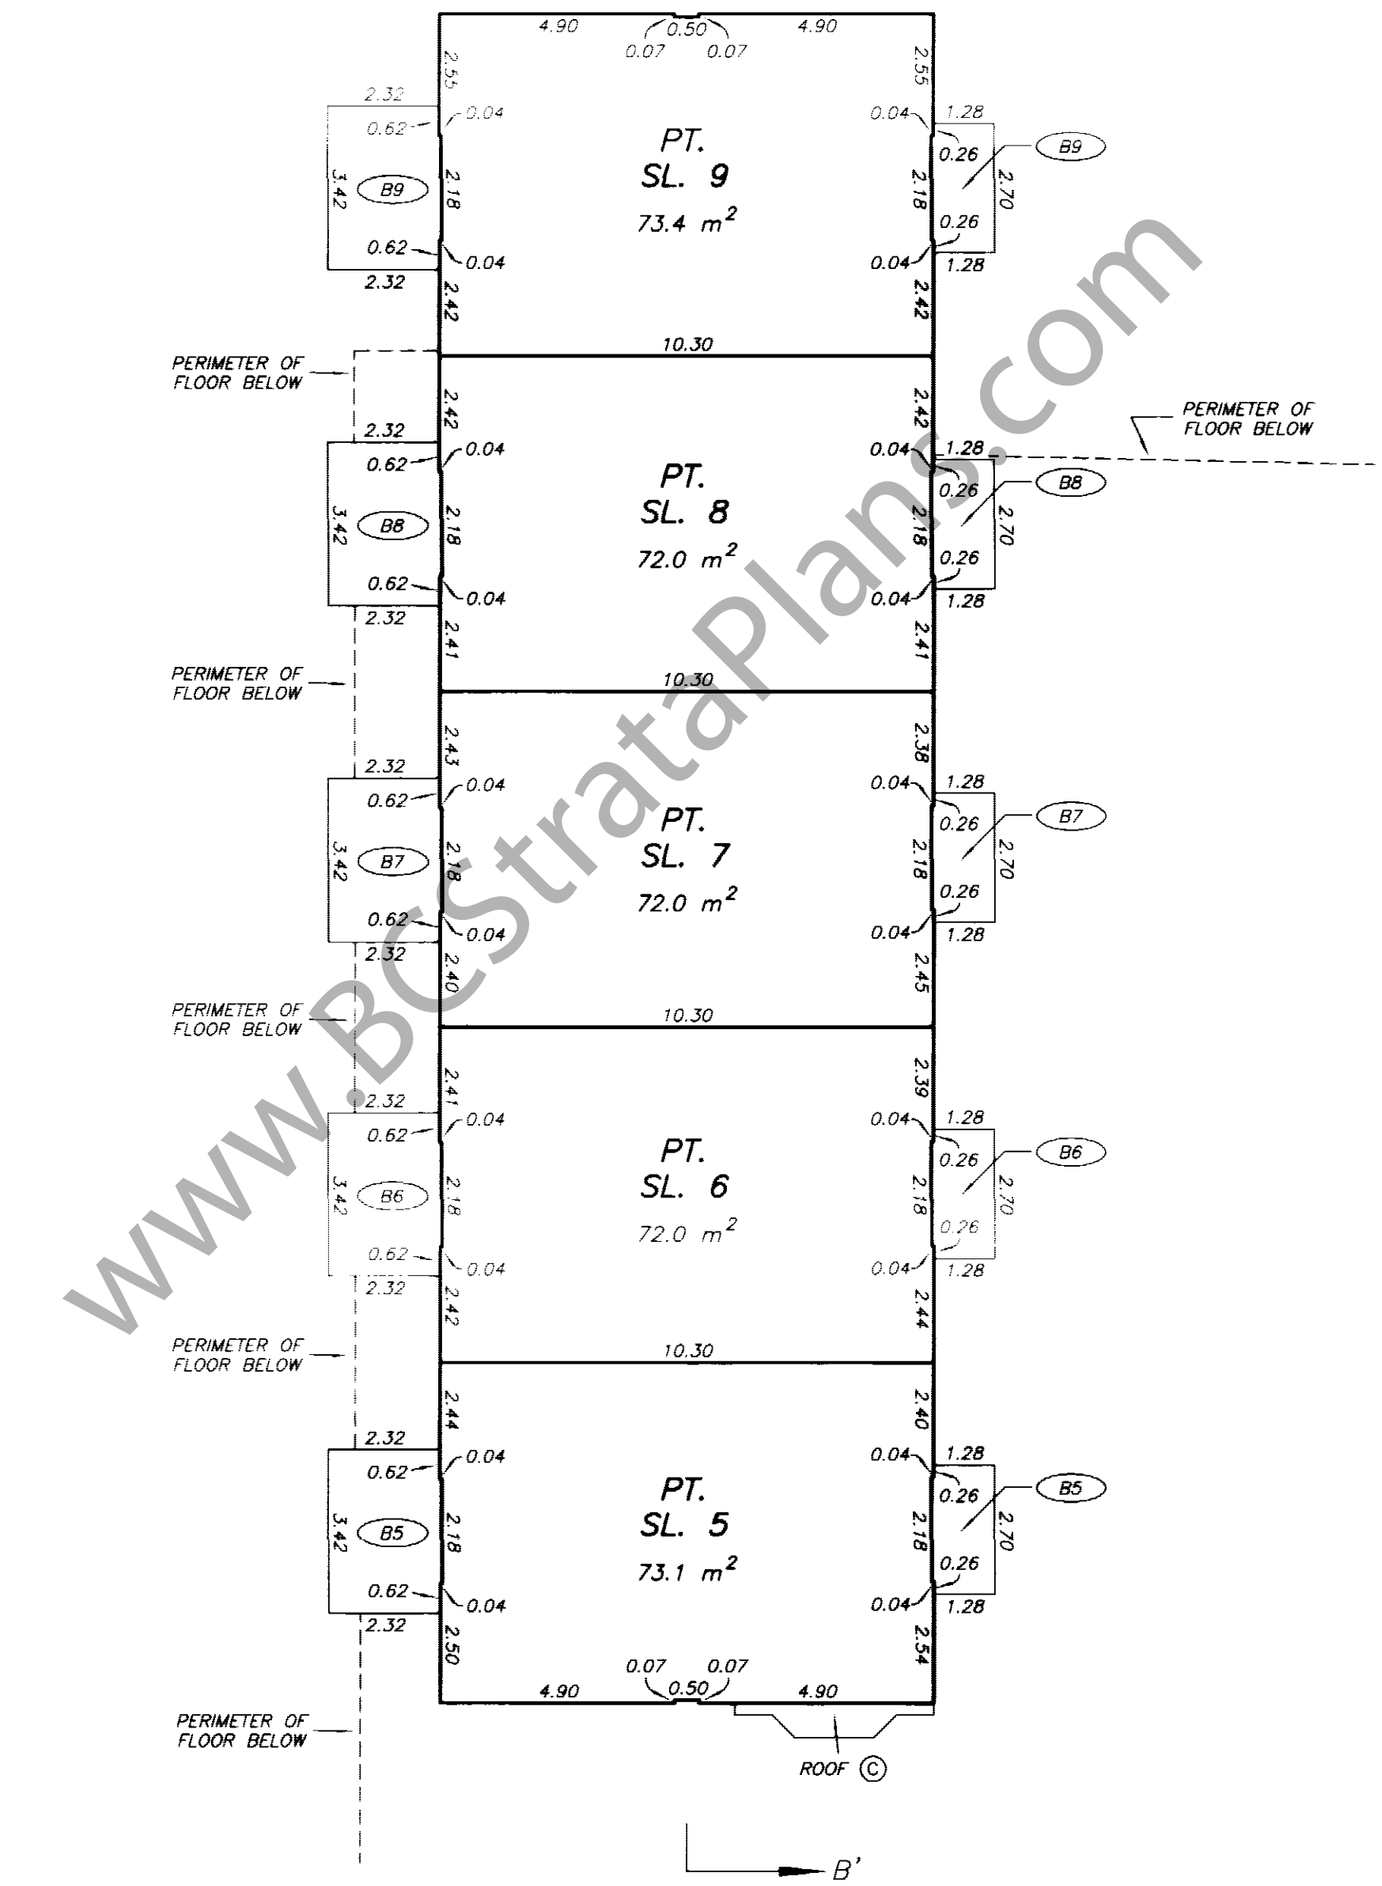

www.BCStrataPlans.com

DRAWING # 30412-20
FILE # 30412-20_TH

DATE : NOVEMBER 25, 2004.

M.E.B.

ORIGINAL

FILED NMBCS1058 T91981 2006-05-17-13.09.44.606497

TOWER MAIN LEVEL FLOOR PLAN

STRATA PLAN BCS 1058

SCALE 1:150

2 0 2 4 6

ALL DISTANCES ARE IN METRES.

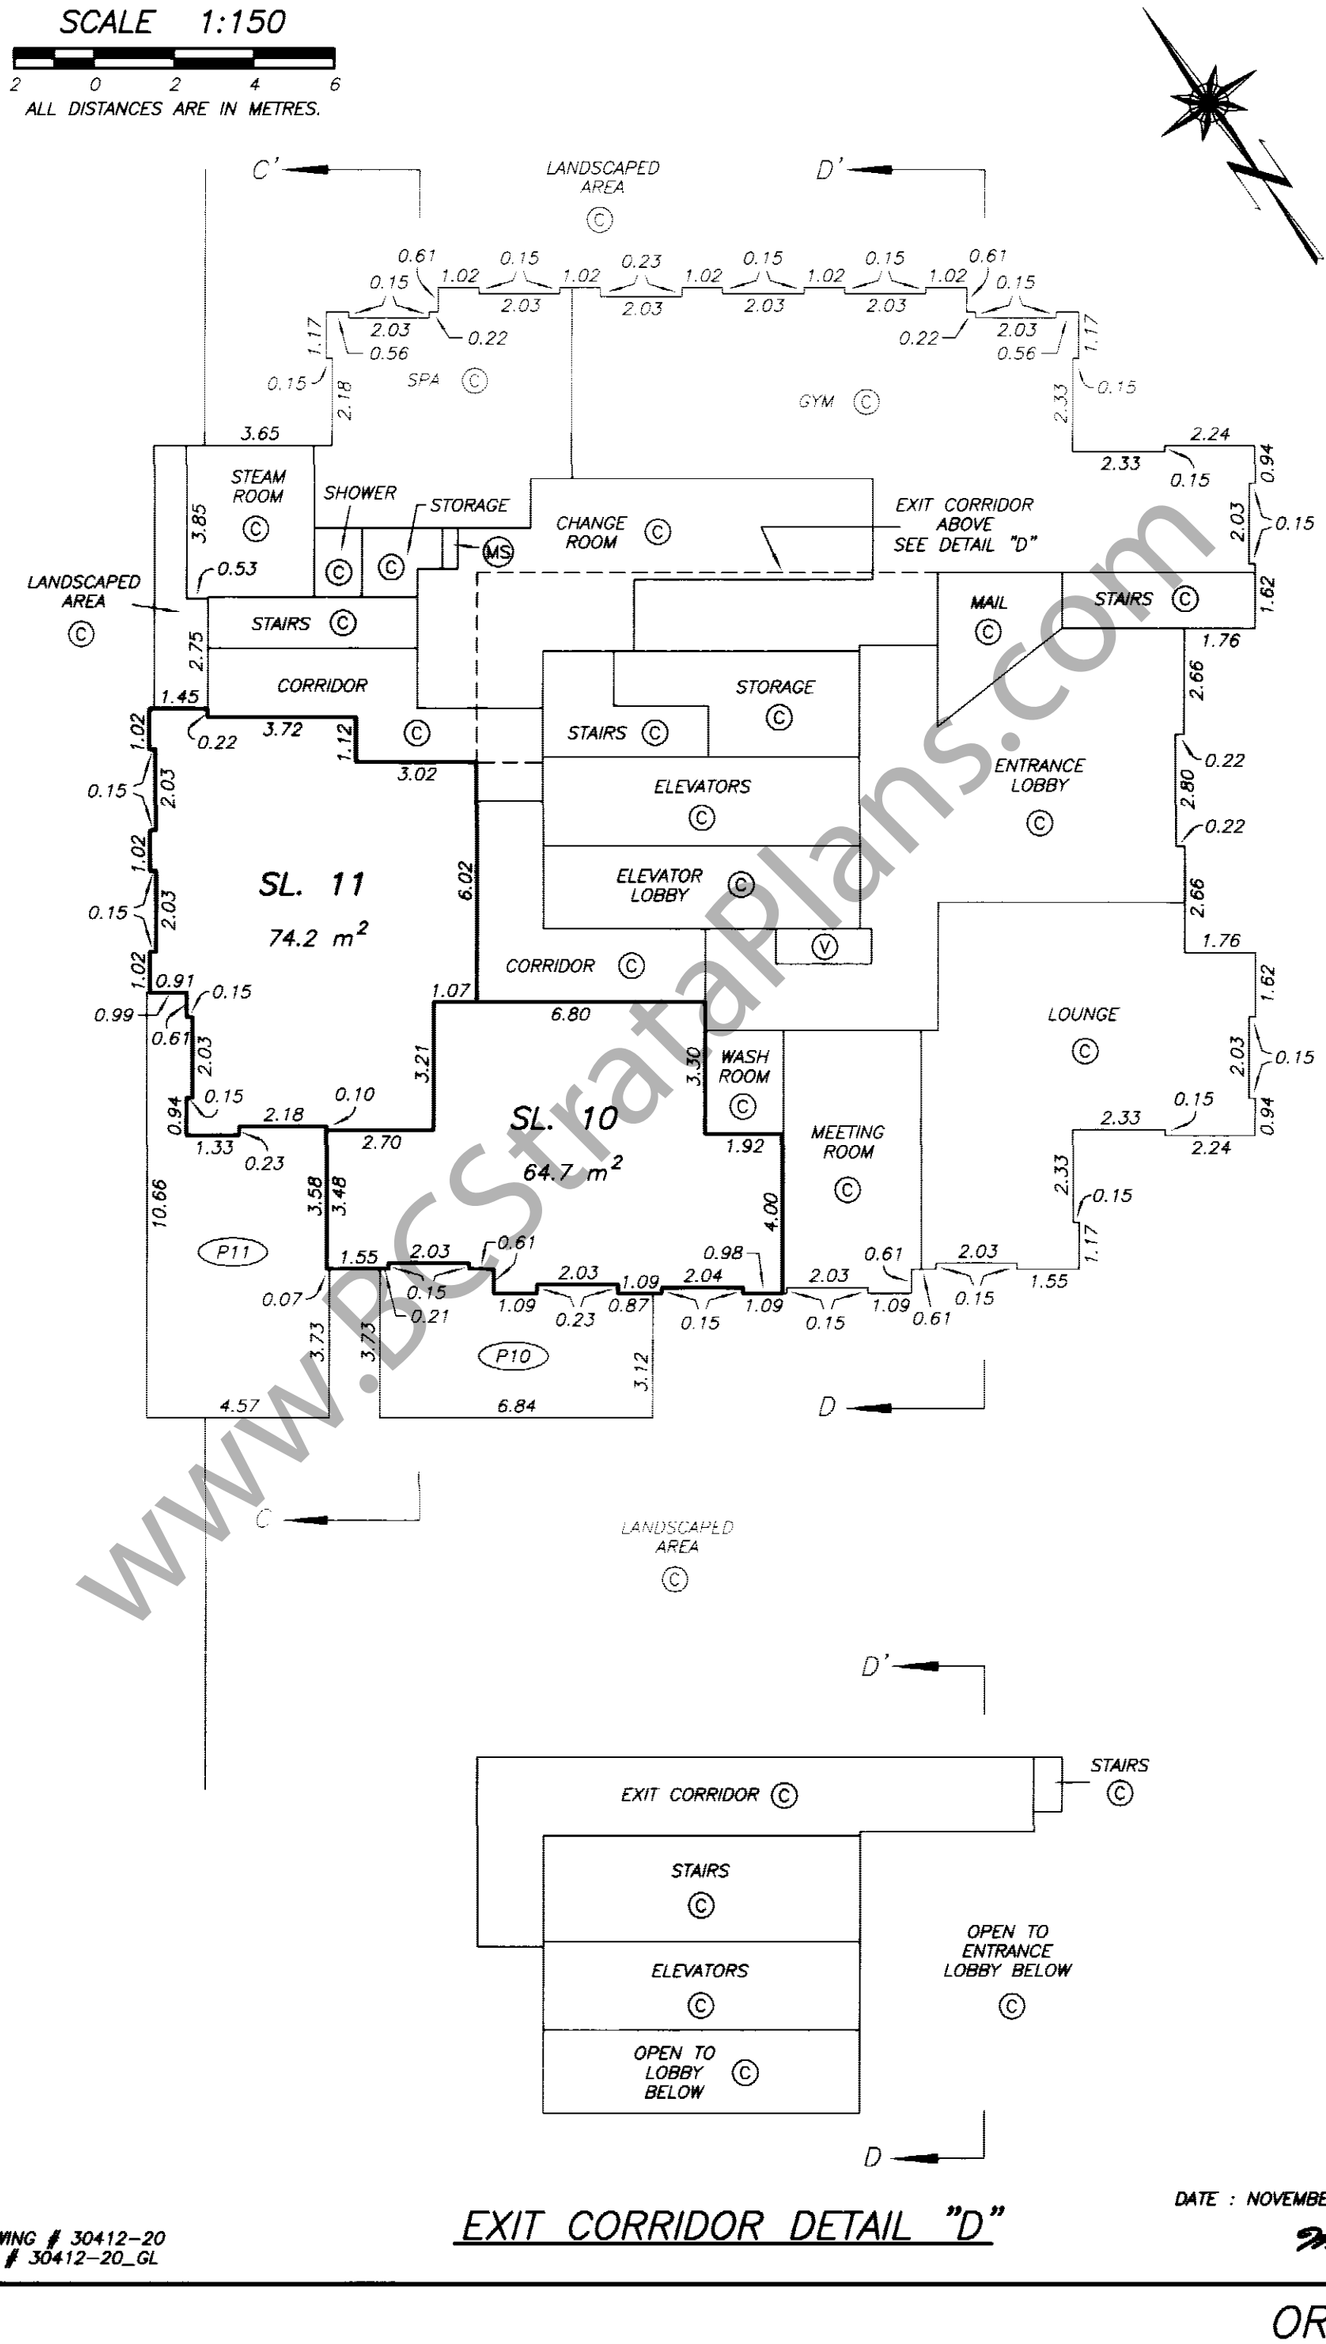

EXIT CORRIDOR DETAIL "D"

DRAWING # 30412-20
FILE # 30412-20_GL

DATE : NOVEMBER 25, 2004.

M.E.S.

ORIGINAL

www.BCStrataPlans.com

FILED NMBCS1058 T91981 2006-05-17-13.09.44.606497

TOWER LEVEL 2 FLOOR PLAN

STRATA PLAN BCS 1058

SCALE 1:150

2 0 2 4 6

ALL DISTANCES ARE IN METRES.

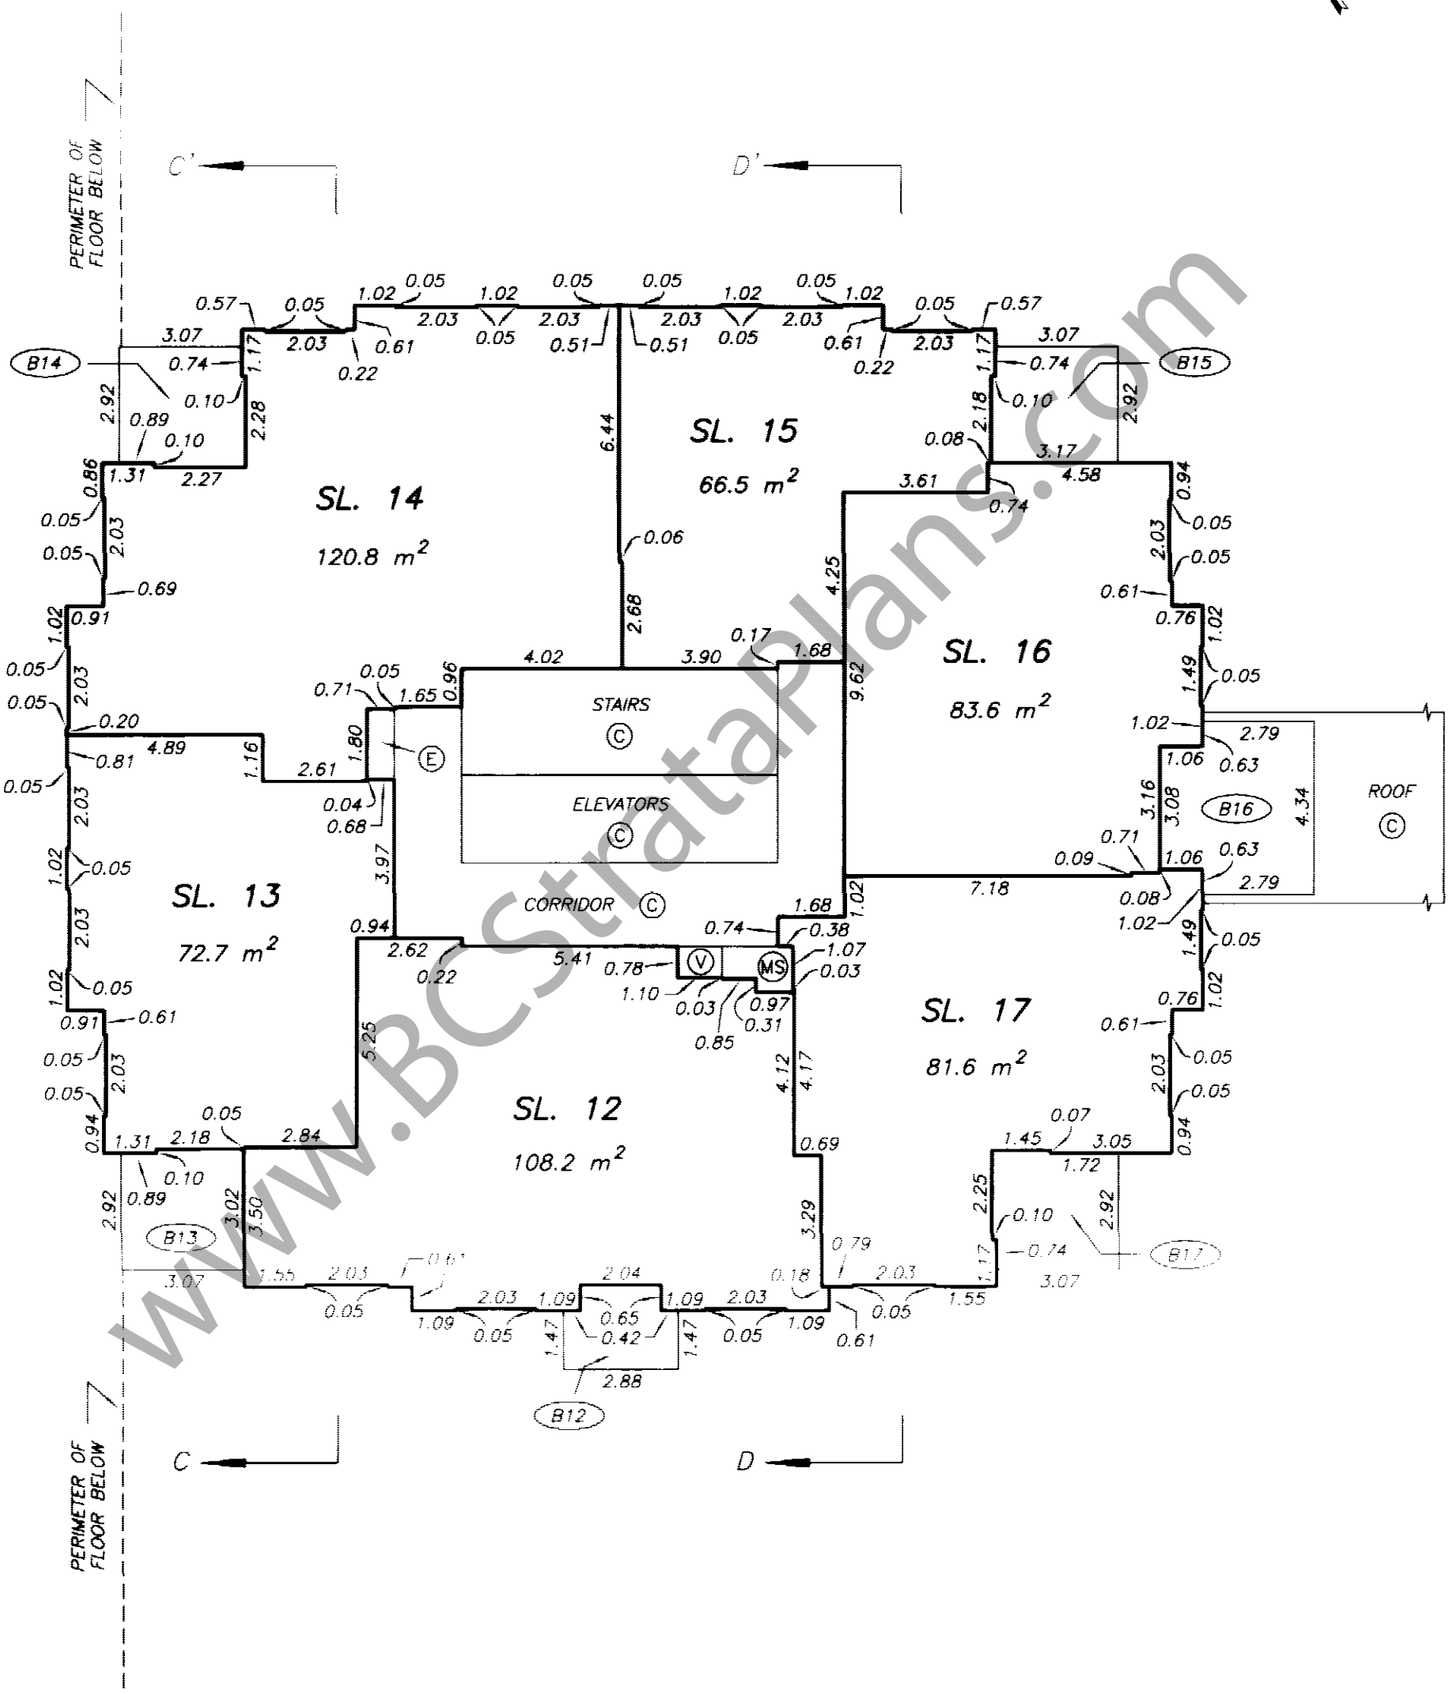

www.BCStrataPlans.com

DRAWING # 30412-20
FILE # 30412-20_T2

DATE : NOVEMBER 25, 2004.

M.E.B.

ORIGINAL

FILED NMBCS1058 T91981 2006-05-17-13.09.44.606497

TOWER LEVEL 3 FLOOR PLAN

STRATA PLAN BCS 1058

SCALE 1:150

2 0 2 4 6

ALL DISTANCES ARE IN METRES.

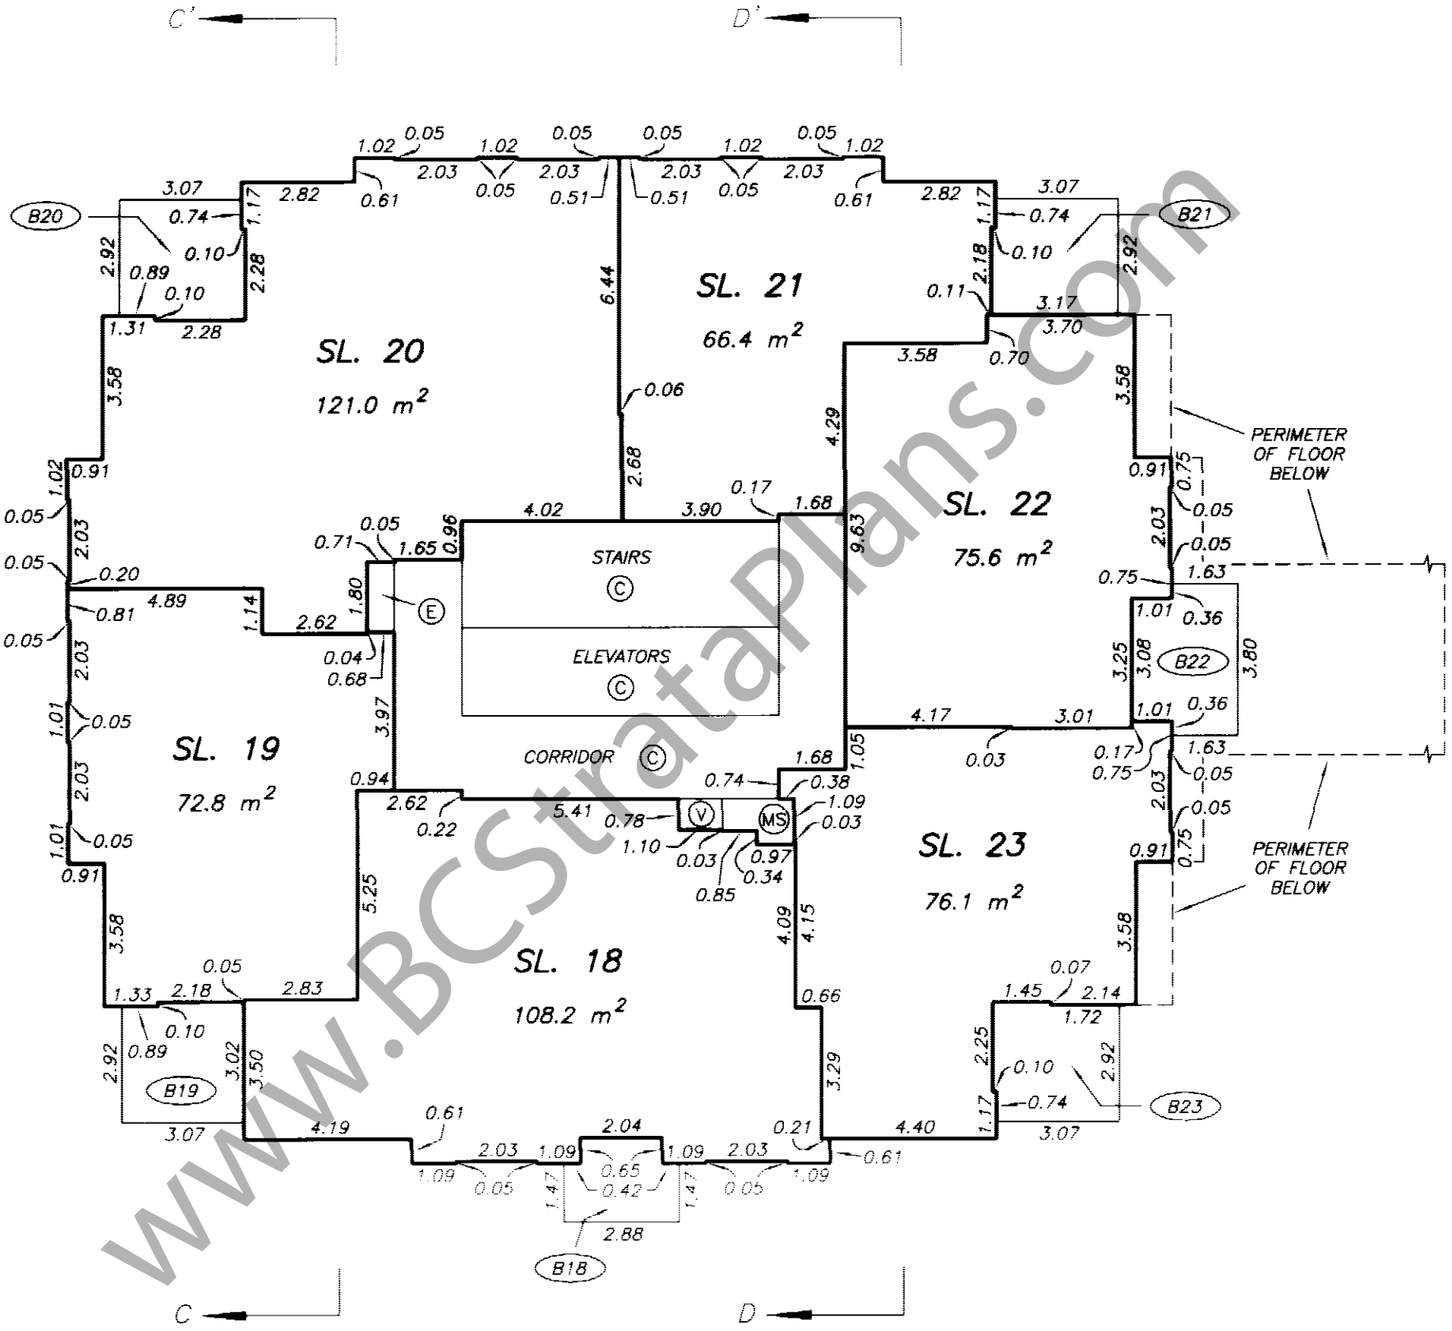

www.BCStrataPlans.com

DRAWING # 30412-20
FILE # 30412-20_T3

DATE : NOVEMBER 25, 2004.

M. C. S.

ORIGINAL

FILED NMBCS1058 T91981 2006-05-17-13.09.44.606497

TOWER LEVEL 5 FLOOR PLAN

STRATA PLAN BCS 1058

SCALE 1:150

2 0 2 4 6

ALL DISTANCES ARE IN METRES.

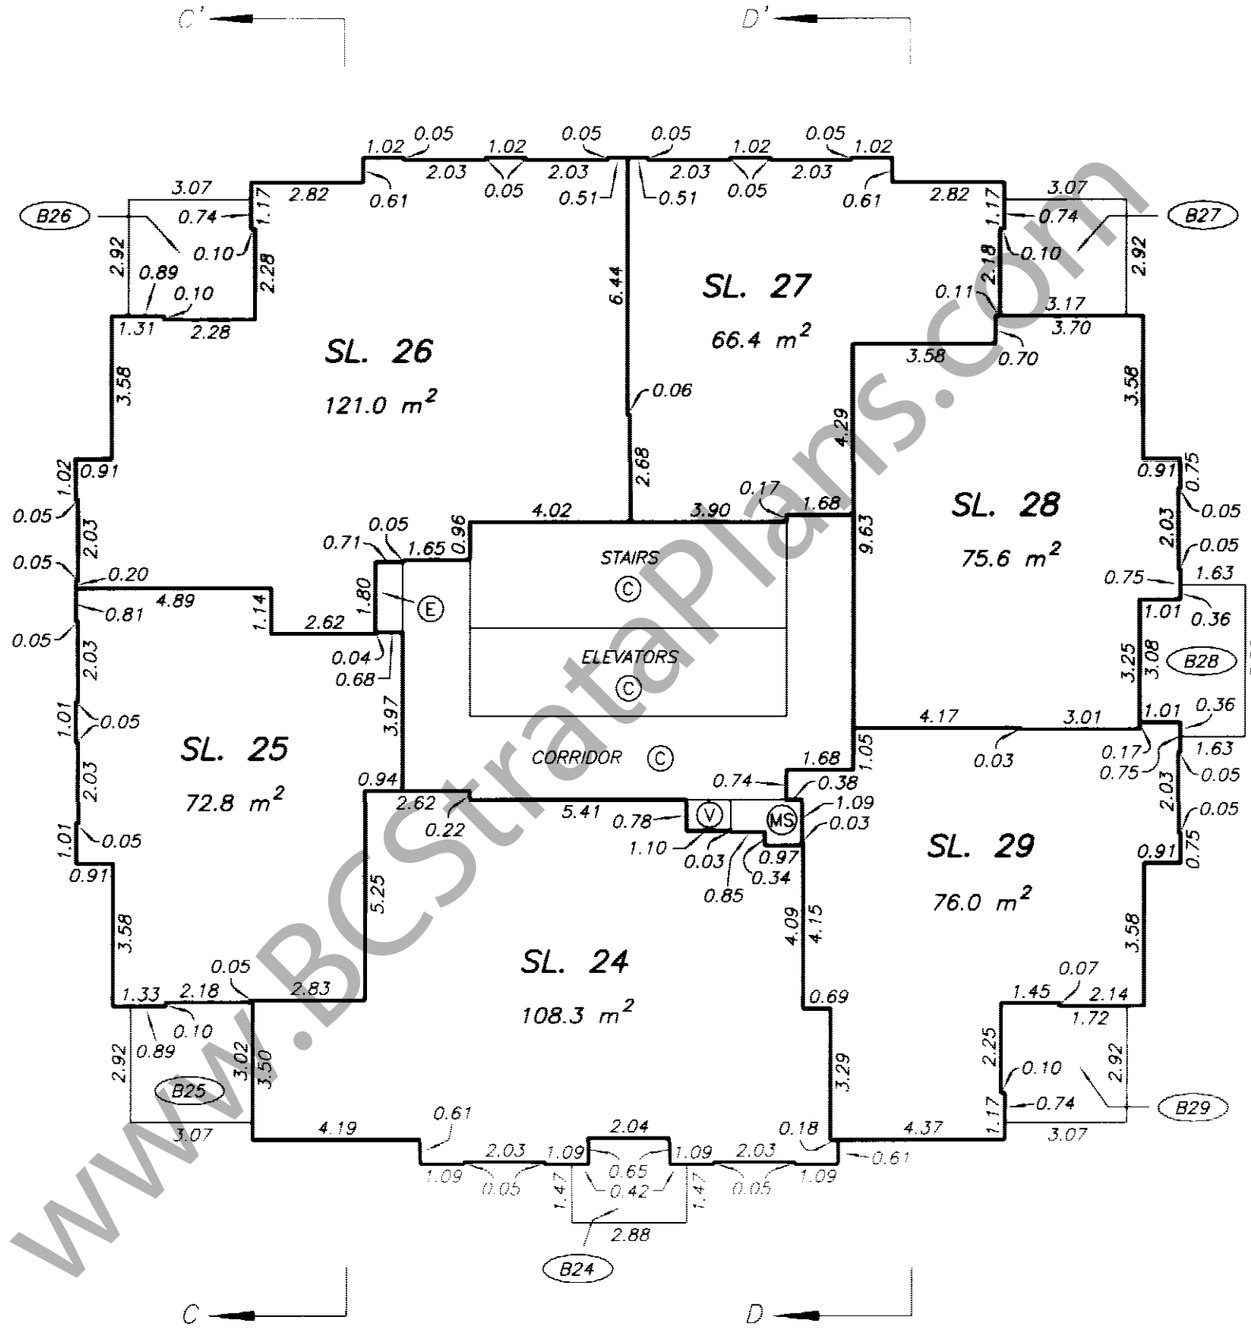

www.BCStrataPlans.com

DRAWING # 30412-20
FILE # 30412-20_T5

DATE : NOVEMBER 25, 2004.

M.E.S.

ORIGINAL

FILED NMBCS1058 T91981 2006-05-17-13.09.44.606497

TOWER LEVEL 6 FLOOR PLAN

STRATA PLAN BCS 1058

SCALE 1:150

2 0 2 4 6

ALL DISTANCES ARE IN METRES.

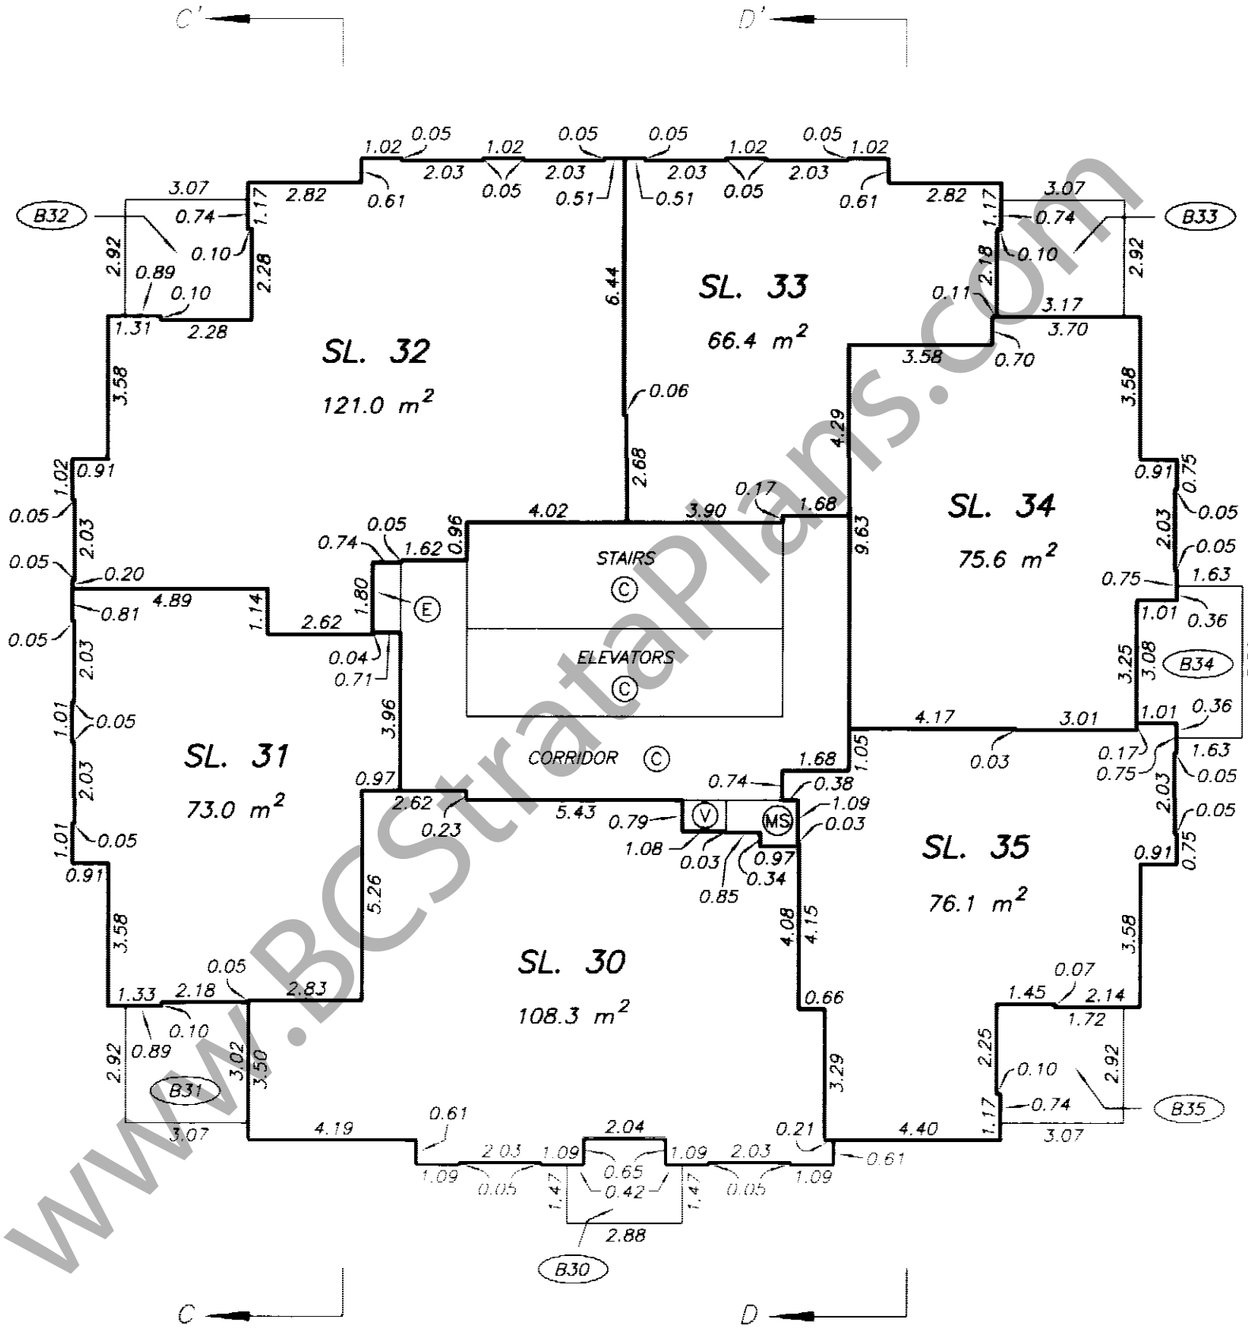

www.BCStrataPlans.com

DRAWING # 30412-20
FILE # 30412-20_T6

DATE : NOVEMBER 25, 2004.

M.E.S.

ORIGINAL

FILED NMBCS1058 T91981 2006-05-17-13.09.44.606497

TOWER LEVEL 7 FLOOR PLAN

STRATA PLAN BCS 1058

SCALE 1:150

2 0 2 4 6

ALL DISTANCES ARE IN METRES.

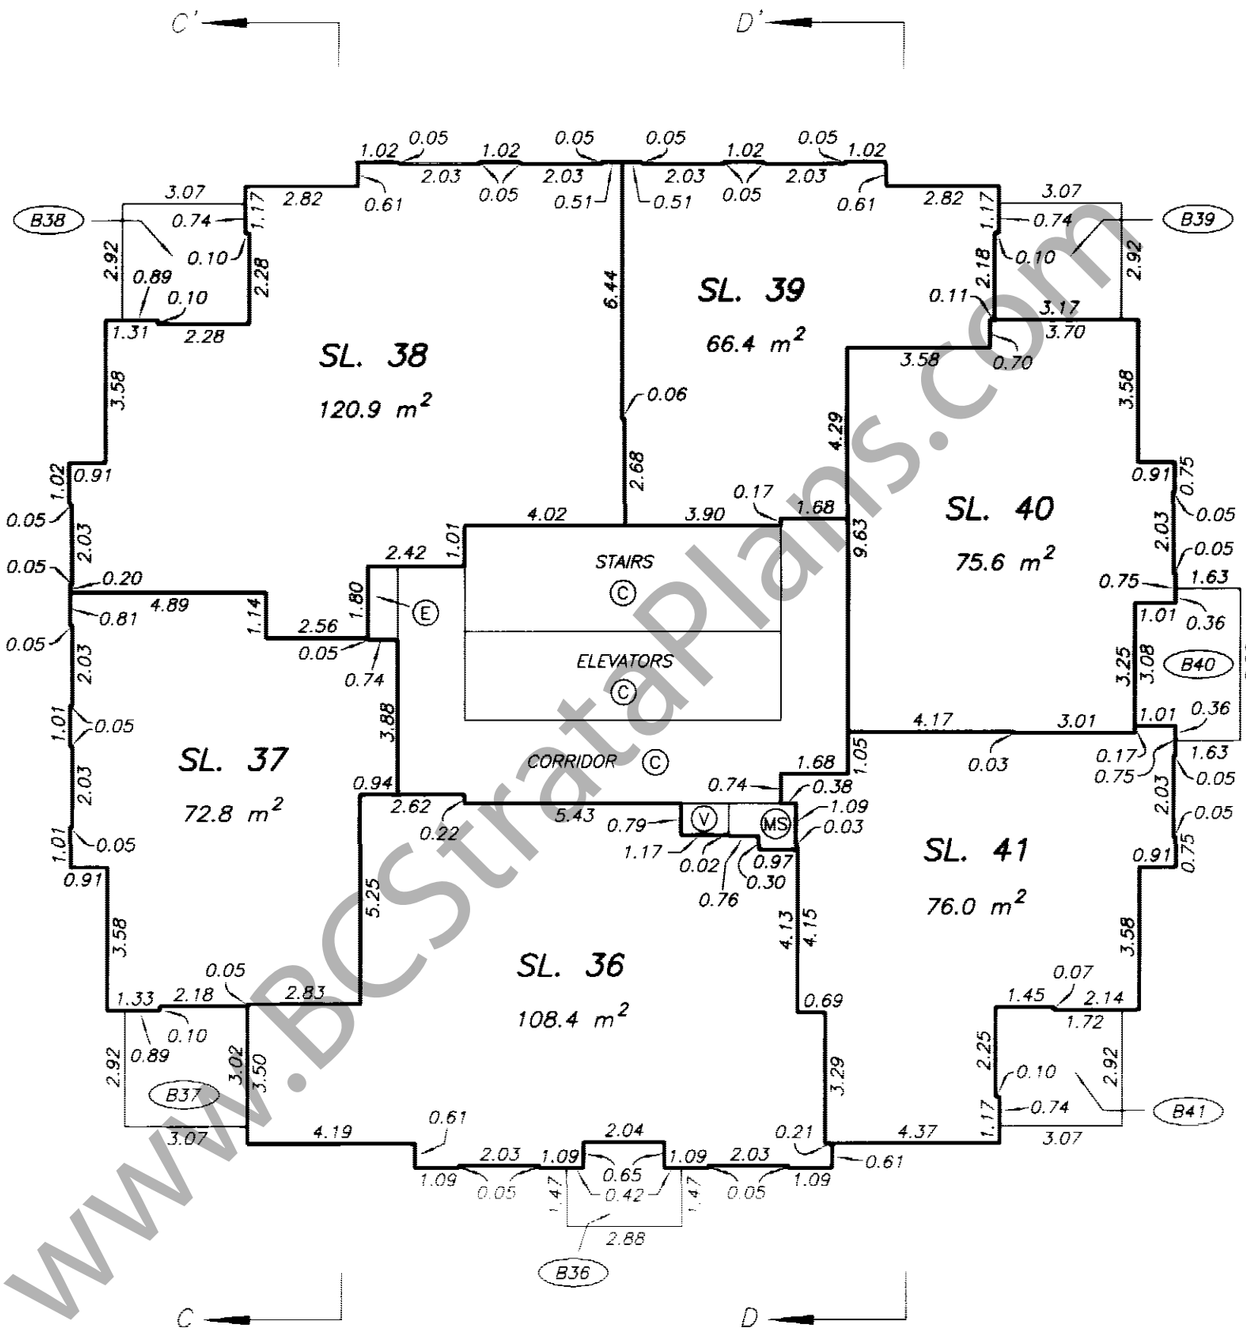

www.BCStrataPlans.com

DRAWING # 30412-20
FILE # 30412-20_T7

DATE : NOVEMBER 25, 2004.

M.E.S.

ORIGINAL

FILED NWBCS1058 T91981 2006-05-17-13.09.44.606497

TOWER LEVEL 8 FLOOR PLAN

STRATA PLAN BCS 1058

SCALE 1:150

2 0 2 4 6

ALL DISTANCES ARE IN METRES.

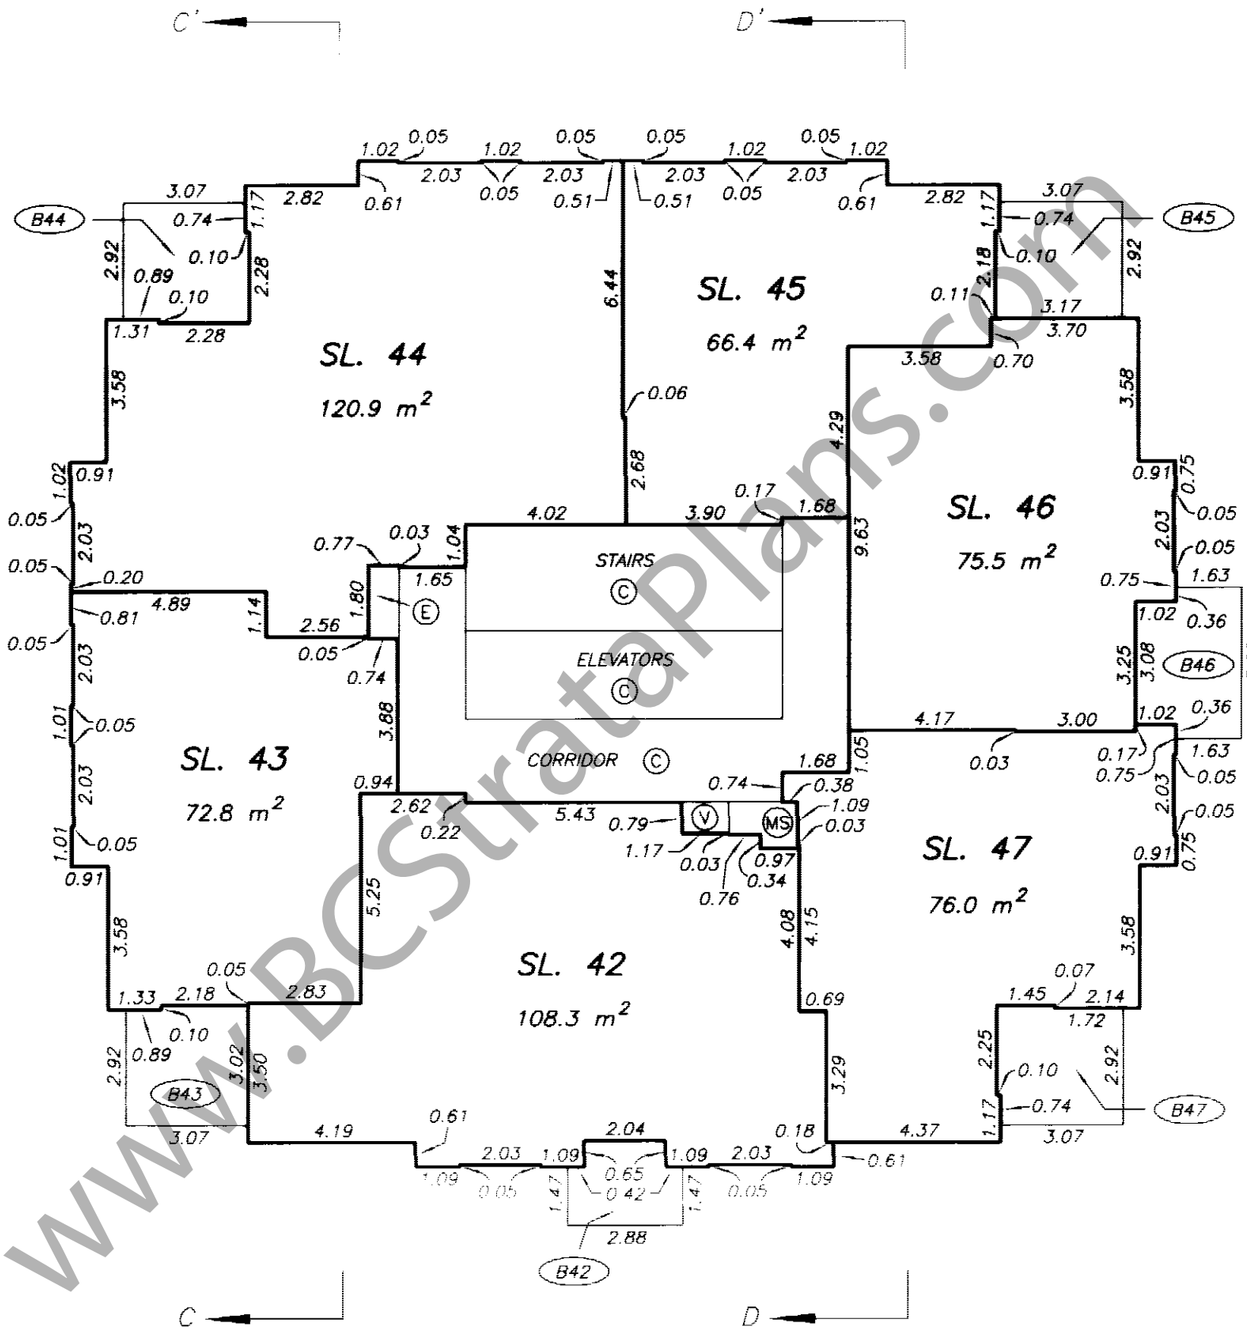

www.BCStrataPlans.com

DRAWING # 30412-20
FILE # 30412-20_T8

DATE : NOVEMBER 25, 2004.

ORIGINAL

FILED NMBCS1058 T91981 2006-05-17-13.09.44.606497

TOWER LEVEL 9 FLOOR PLAN

STRATA PLAN BCS 1058

SCALE 1:150

2 0 2 4 6

ALL DISTANCES ARE IN METRES.

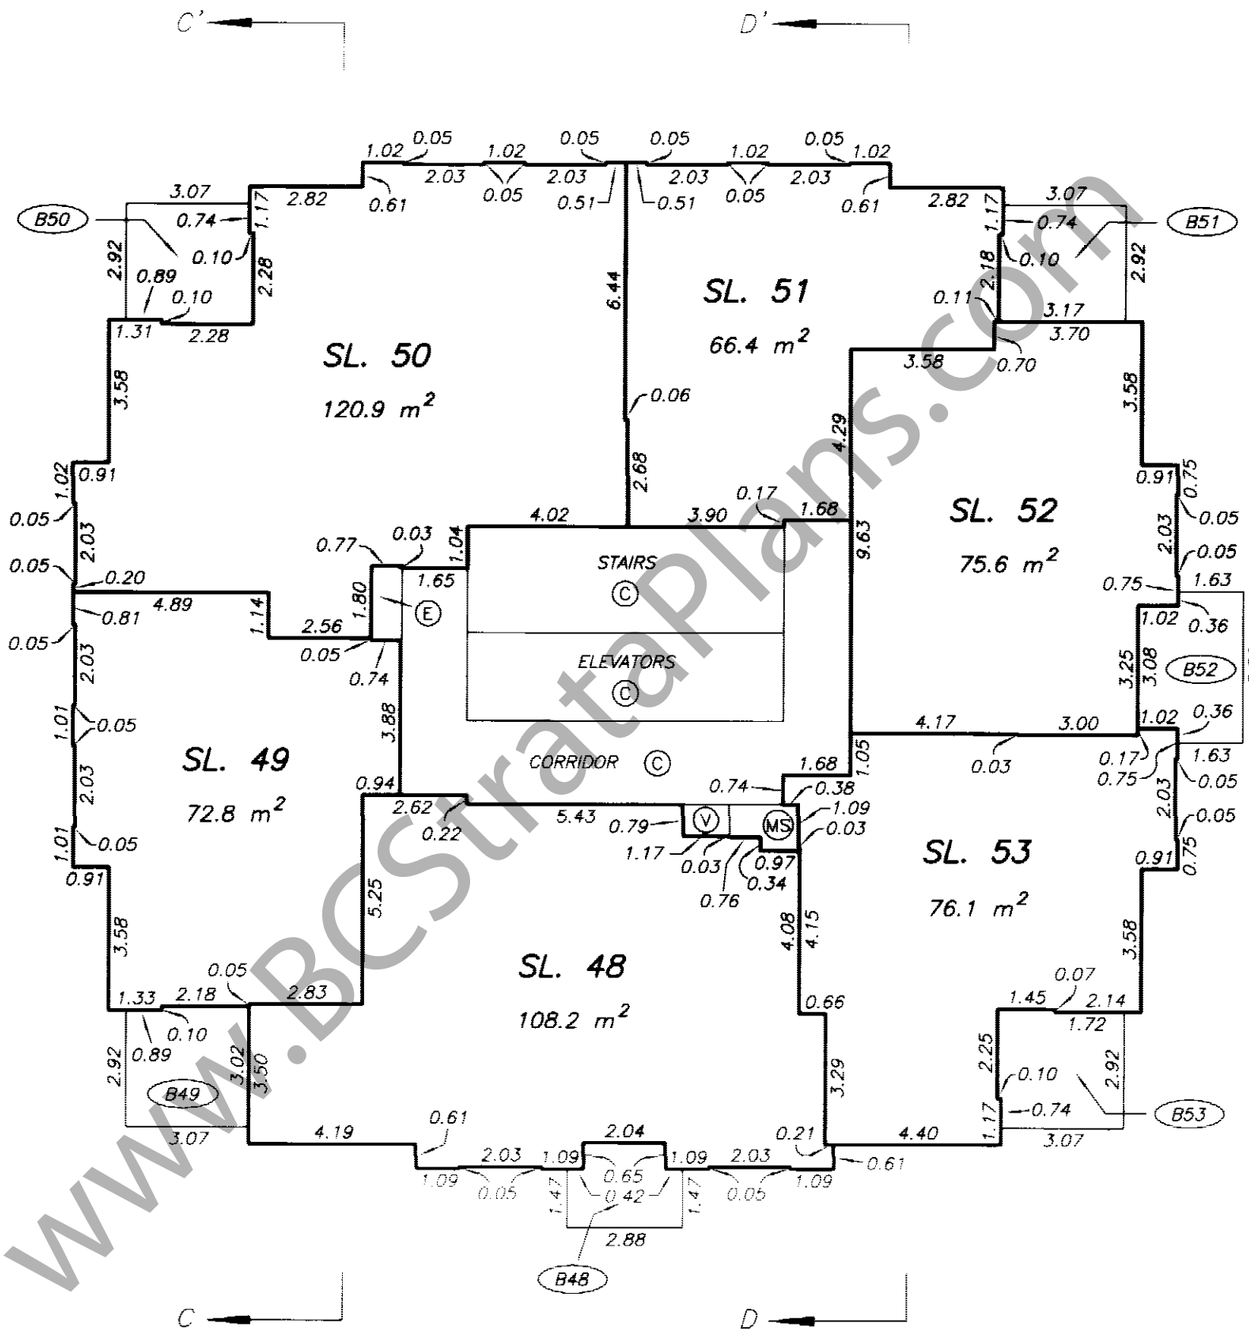

www.BCStrataPlans.com

DRAWING # 30412-20
FILE # 30412-20_T9

DATE : NOVEMBER 25, 2004.

M.E.B.

ORIGINAL

FILED NWBCS1058 T91981 2006-05-17-13.09.44.606497

TOWER LEVEL 10 FLOOR PLAN

STRATA PLAN BCS 1058

SCALE 1:150

2 0 2 4 6

ALL DISTANCES ARE IN METRES.

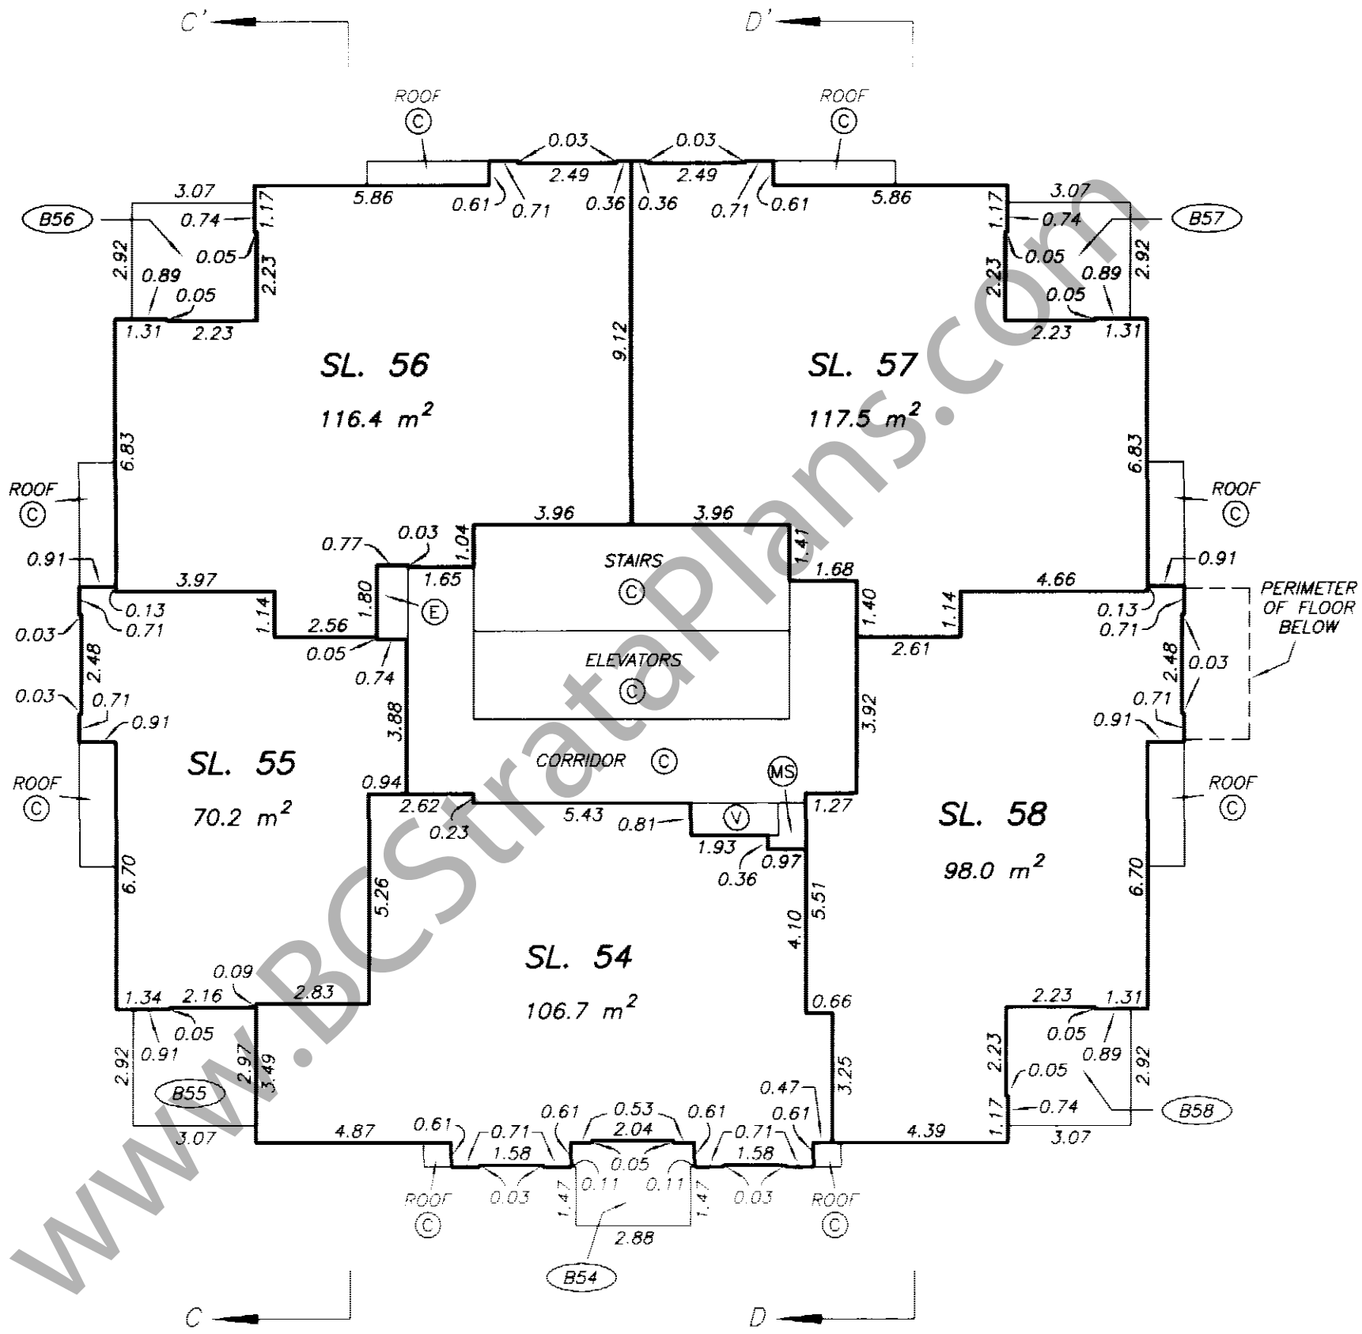

www.BCStrataPlans.com

DRAWING # 30412-20
FILE # 30412-20_T10

DATE : NOVEMBER 25, 2004.

M. E. B.

ORIGINAL

FILED NMBCS1058 T91981 2006-05-17-13.09.44.606497

TOWER LEVEL 11 FLOOR PLAN

STRATA PLAN BCS 1058

SCALE 1:150

2 0 2 4 6

ALL DISTANCES ARE IN METRES.

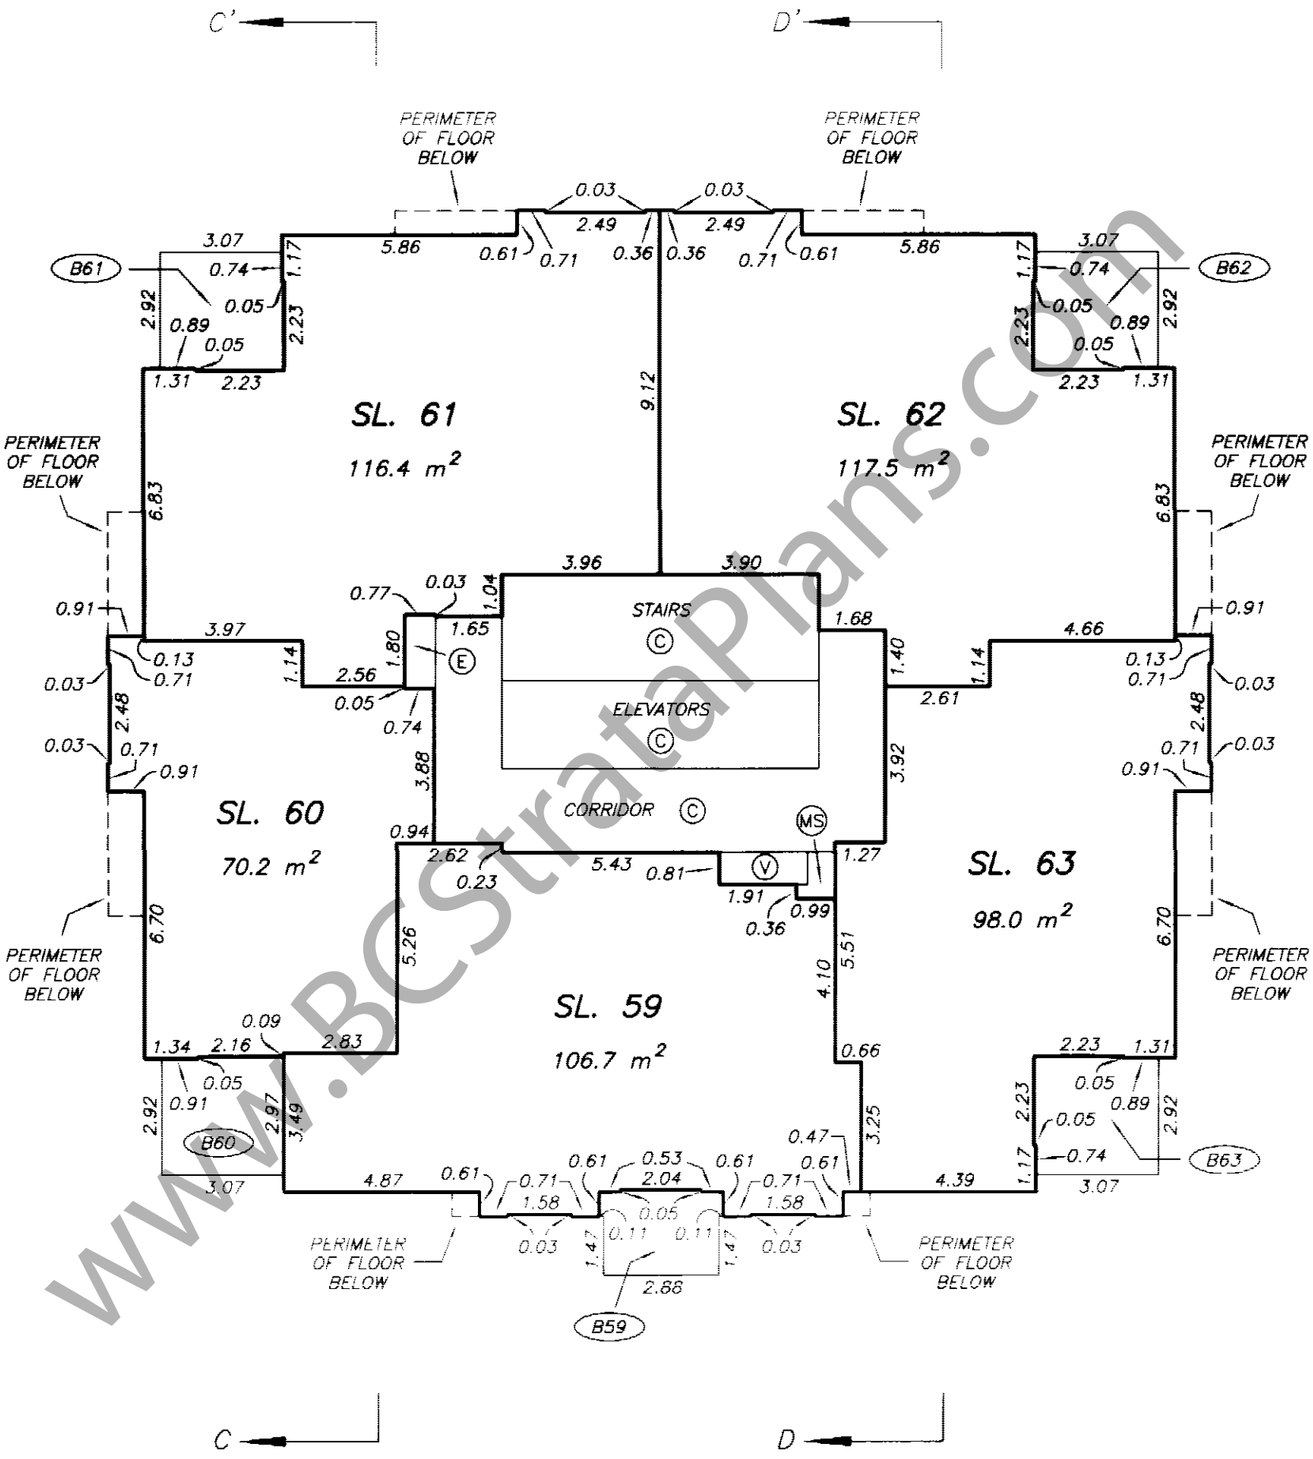

www.BCStrataPlans.com

DRAWING # 30412-20
FILE # 30412-20_T11

DATE : NOVEMBER 25, 2004.

M.E.S.

ORIGINAL

FILED NMBCS1058 T91981 2006-05-17-13.09.44.606497

TOWER LEVEL 12 FLOOR PLAN

STRATA PLAN BCS 1058

SCALE 1:150

2 0 2 4 6

ALL DISTANCES ARE IN METRES.

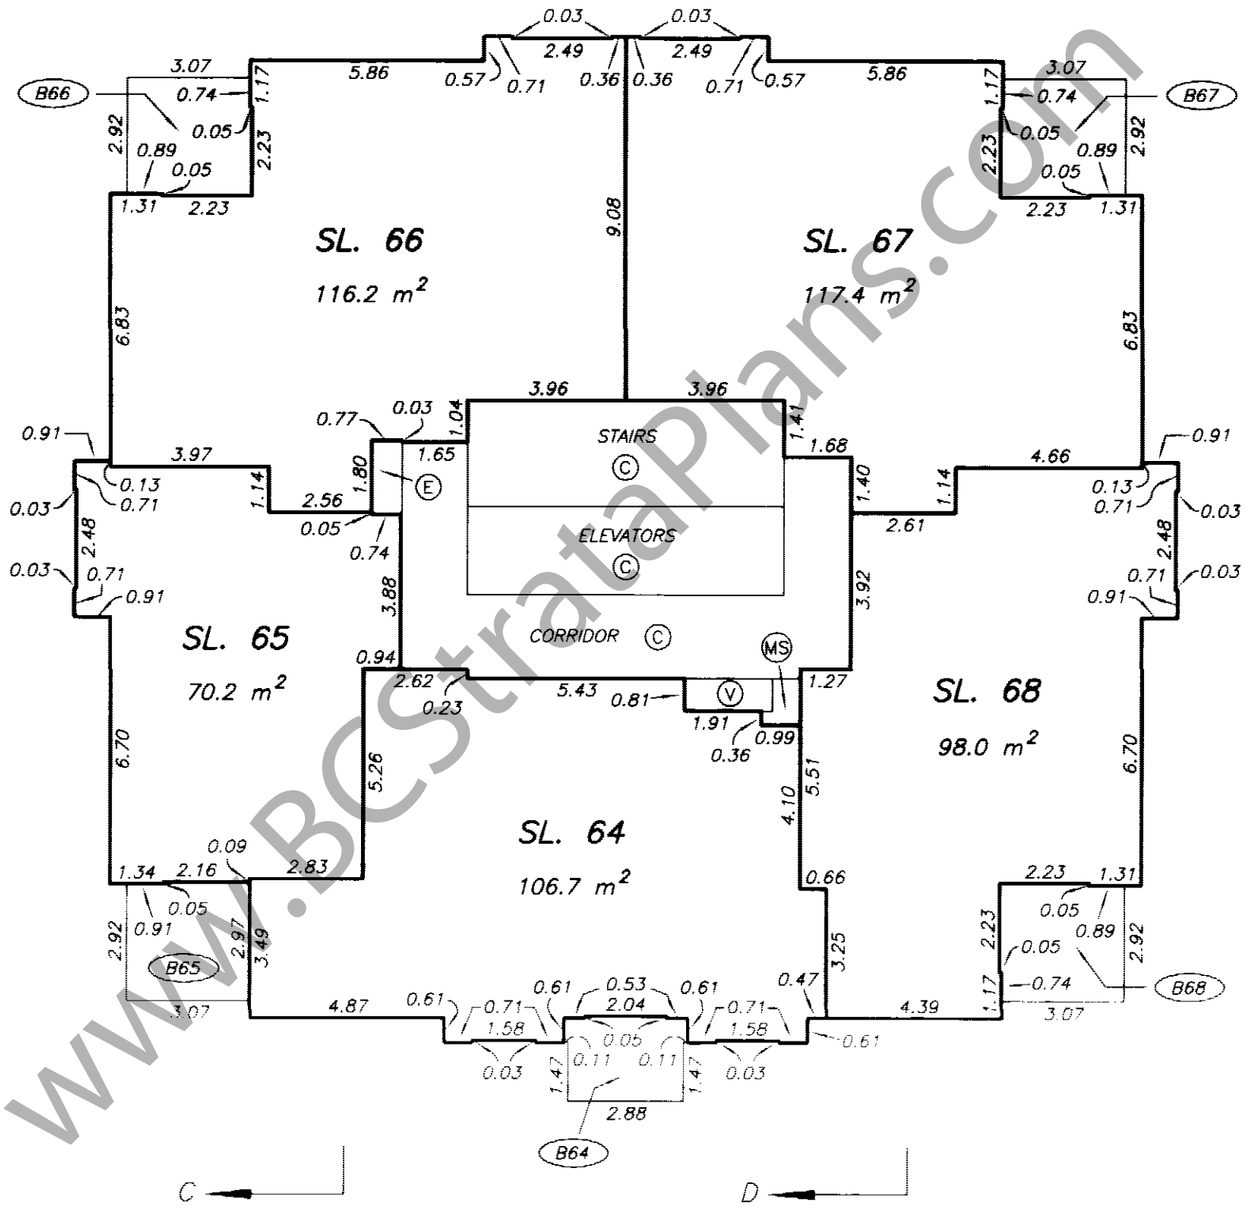

www.BCStrataPlans.com

DRAWING # 30412-20
FILE # 30412-20_T12

DATE : NOVEMBER 25, 2004.

M.E.S.

ORIGINAL

FILED NMBCS1058 T91981 2006-05-17-13.09.44.606497

TOWER LEVEL 14 FLOOR PLAN

STRATA PLAN BCS 1058

SCALE 1:150

2 0 2 4 6

ALL DISTANCES ARE IN METRES.

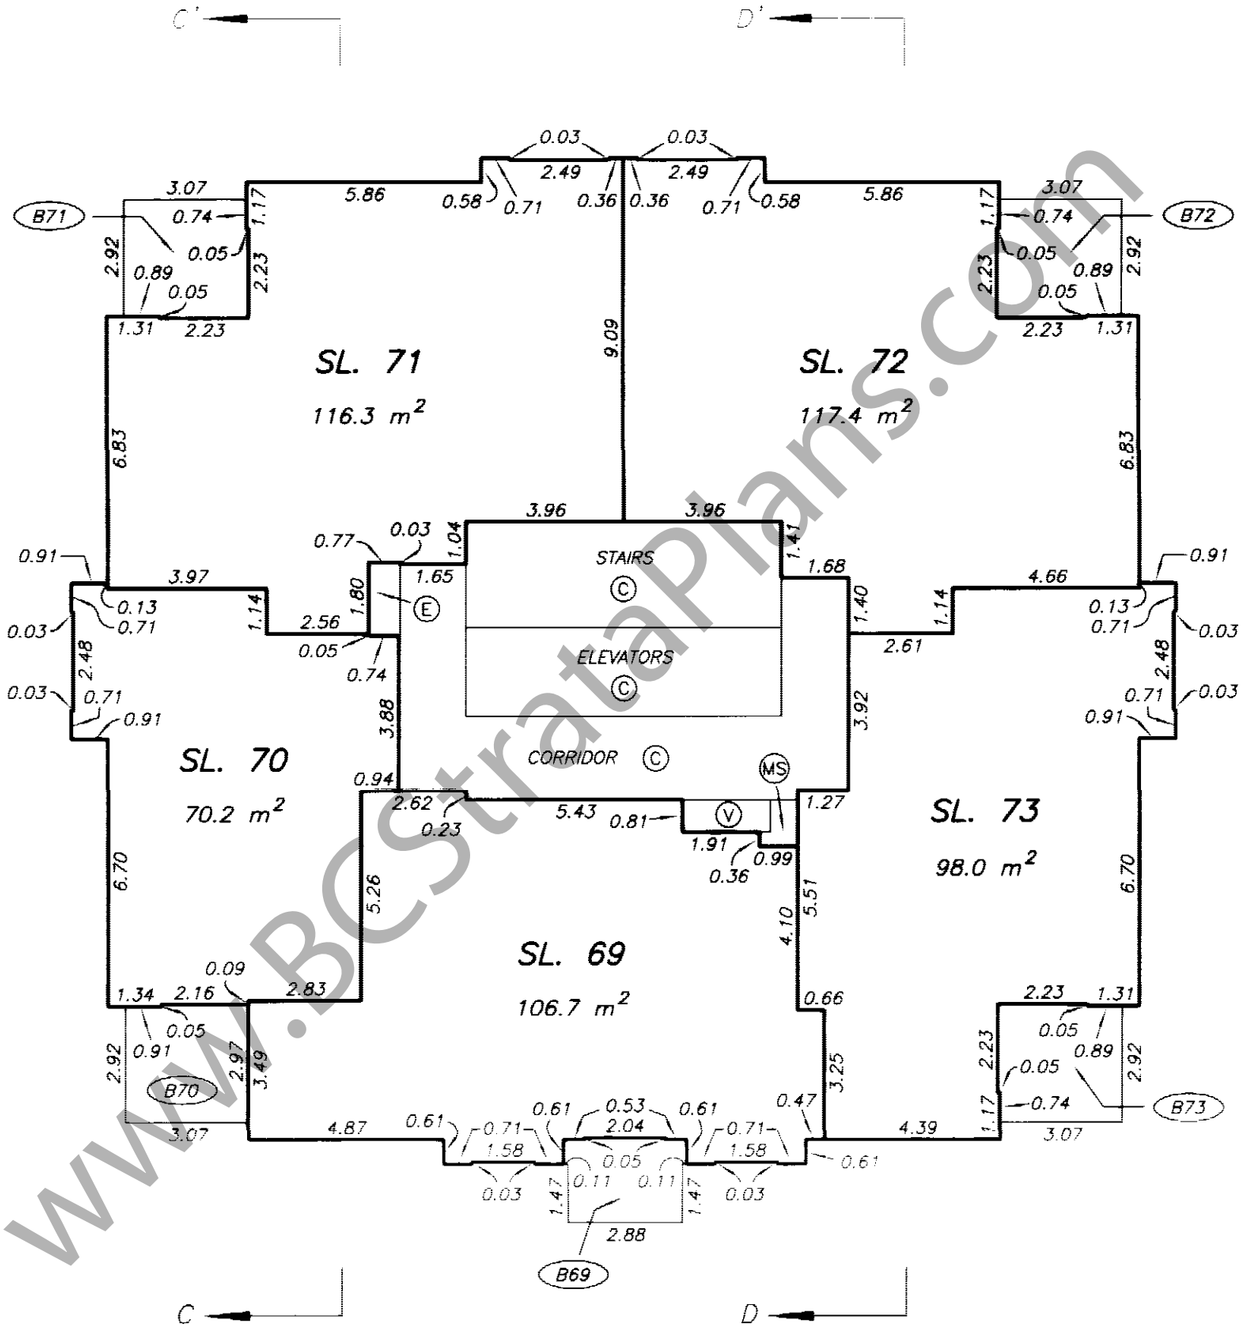

www.BCStrataPlans.com

DRAWING # 30412-20
FILE # 30412-20_T14

DATE : NOVEMBER 25, 2004.

M.E.S.

ORIGINAL

FILED NMBCS1058 T91981 2006-05-17-13.09.44.606497

TOWER LEVEL 15 FLOOR PLAN

STRATA PLAN BCS 1058

SCALE 1:150

2 0 2 4 6

ALL DISTANCES ARE IN METRES.

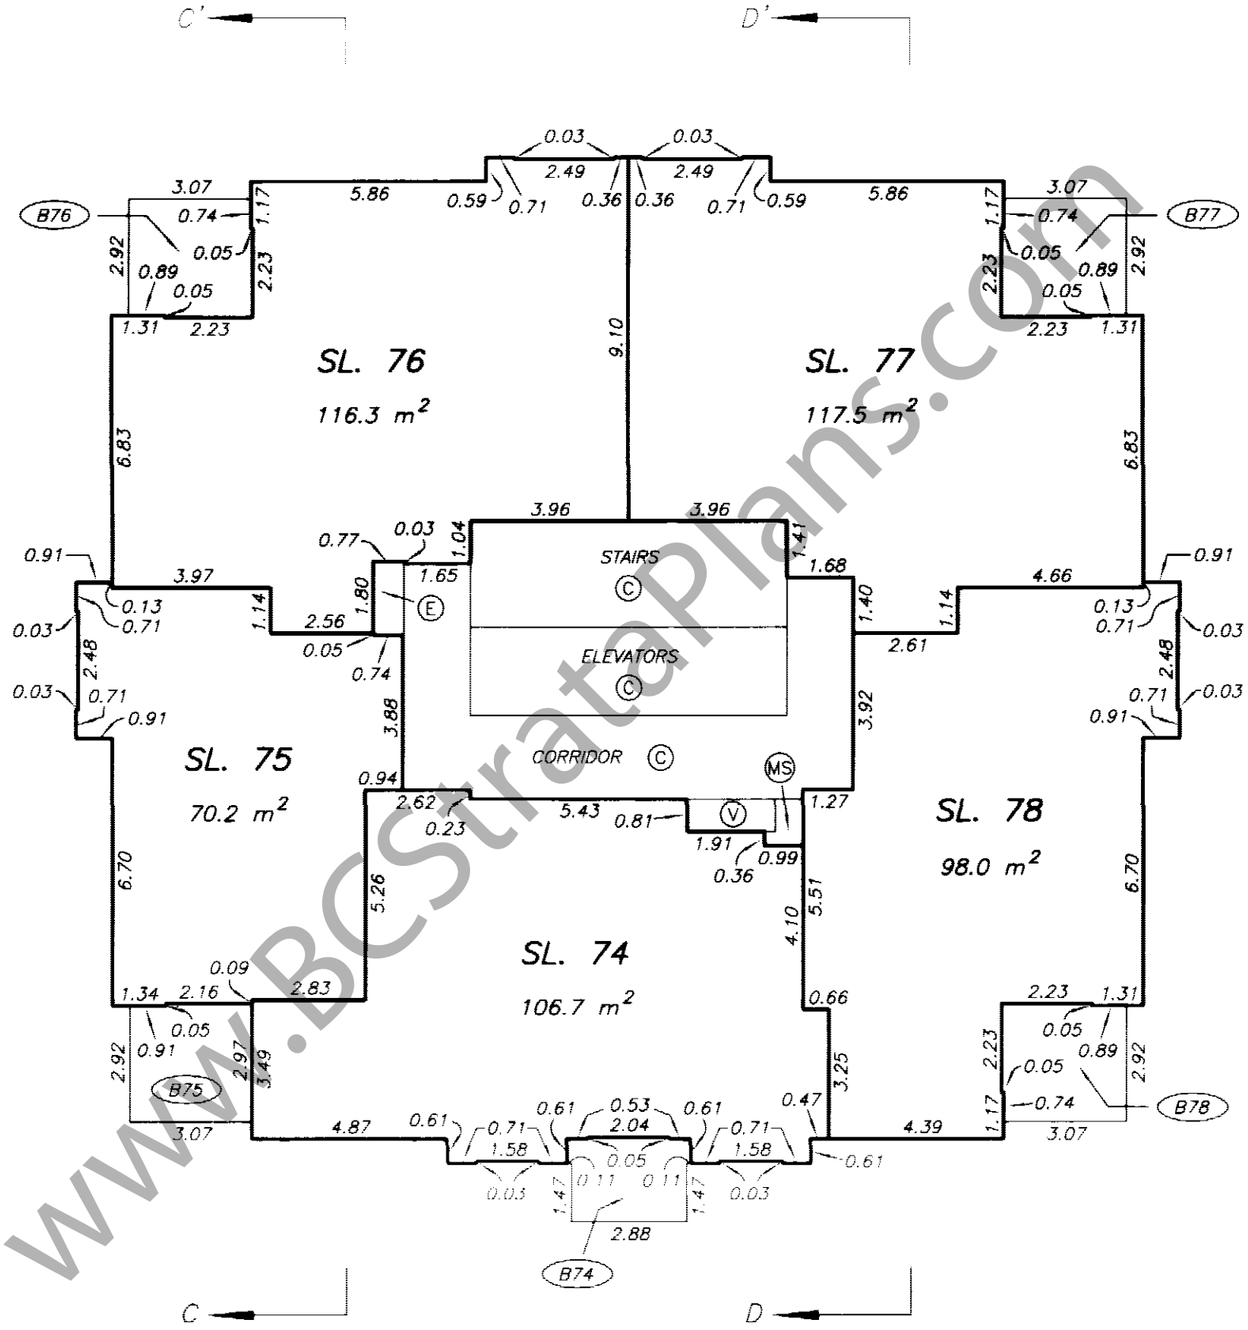

www.BCStrataPlans.com

DRAWING # 30412-20
FILE # 30412-20_T15

DATE : NOVEMBER 25, 2004.

M.E.S.

ORIGINAL

FILED NMBCS1058 T91981 2006-05-17-13.09.44.606497

TOWER LEVEL 16 FLOOR PLAN

STRATA PLAN BCS 1058

SCALE 1:150

2 0 2 4 6

ALL DISTANCES ARE IN METRES.

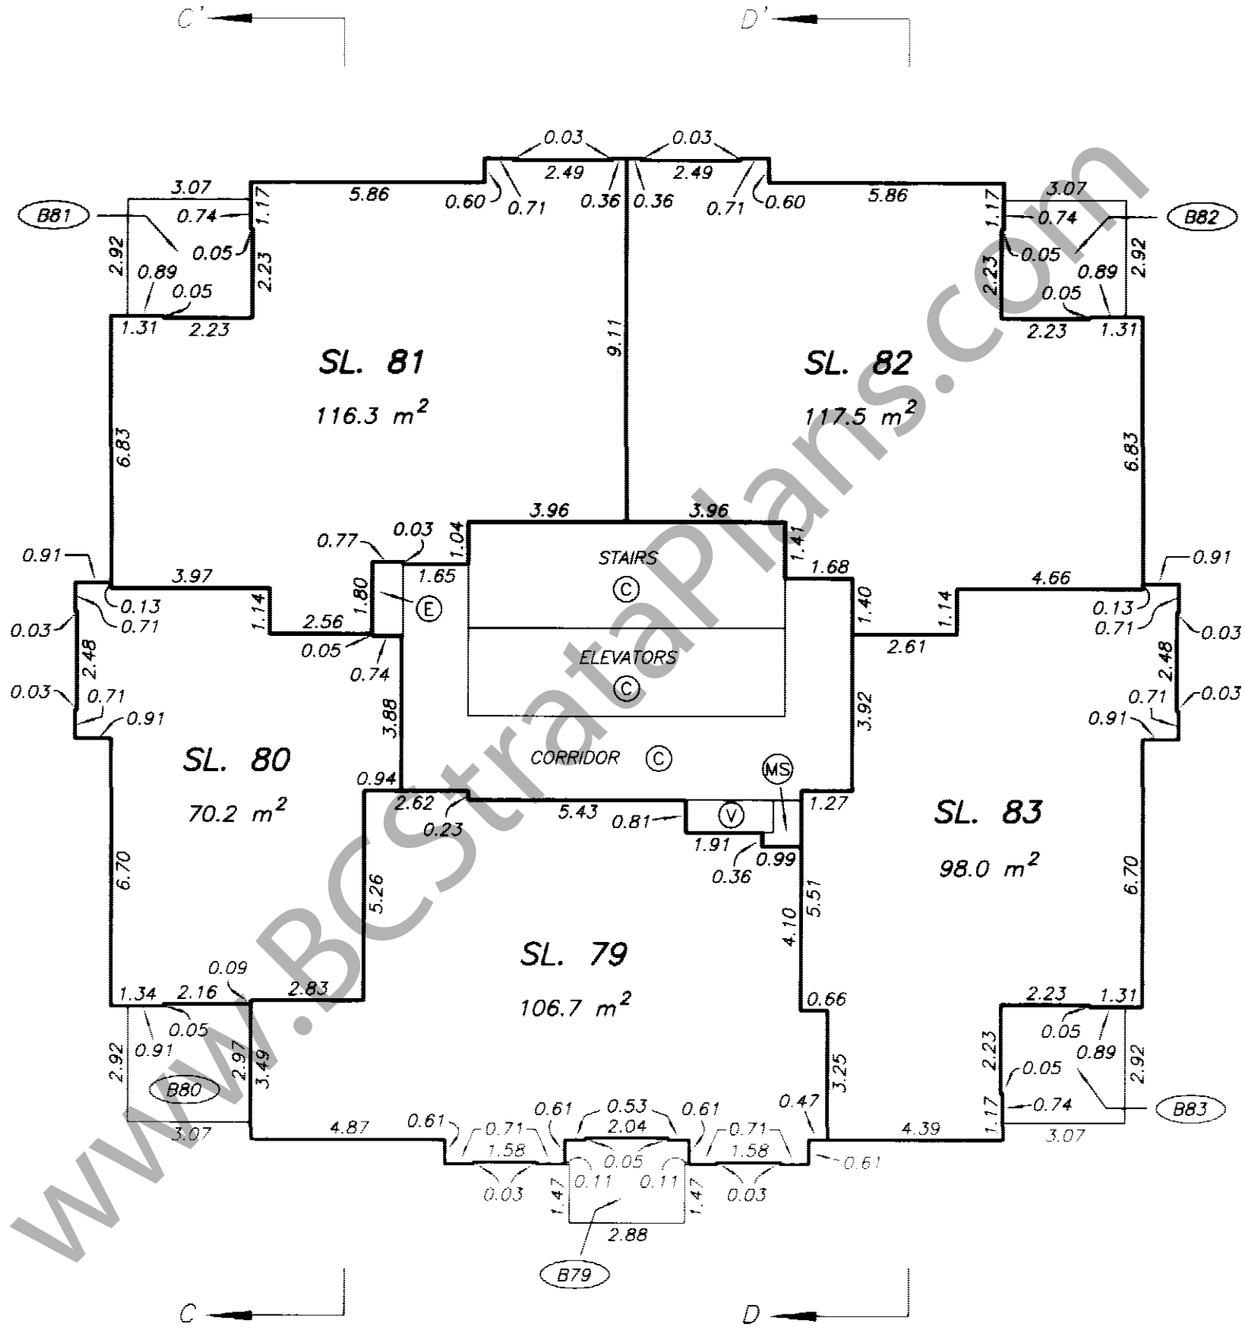

www.BCStrataPlans.com

DRAWING # 30412-20
FILE # 30412-20_T16

DATE : NOVEMBER 25, 2004.

M. E. B.

ORIGINAL

FILED NMBCS1058 T91981 2006-05-17-13.09.44.606497

TOWER LEVEL 17 FLOOR PLAN

STRATA PLAN BCS 1058

SCALE 1:150

2 0 2 4 6

ALL DISTANCES ARE IN METRES.

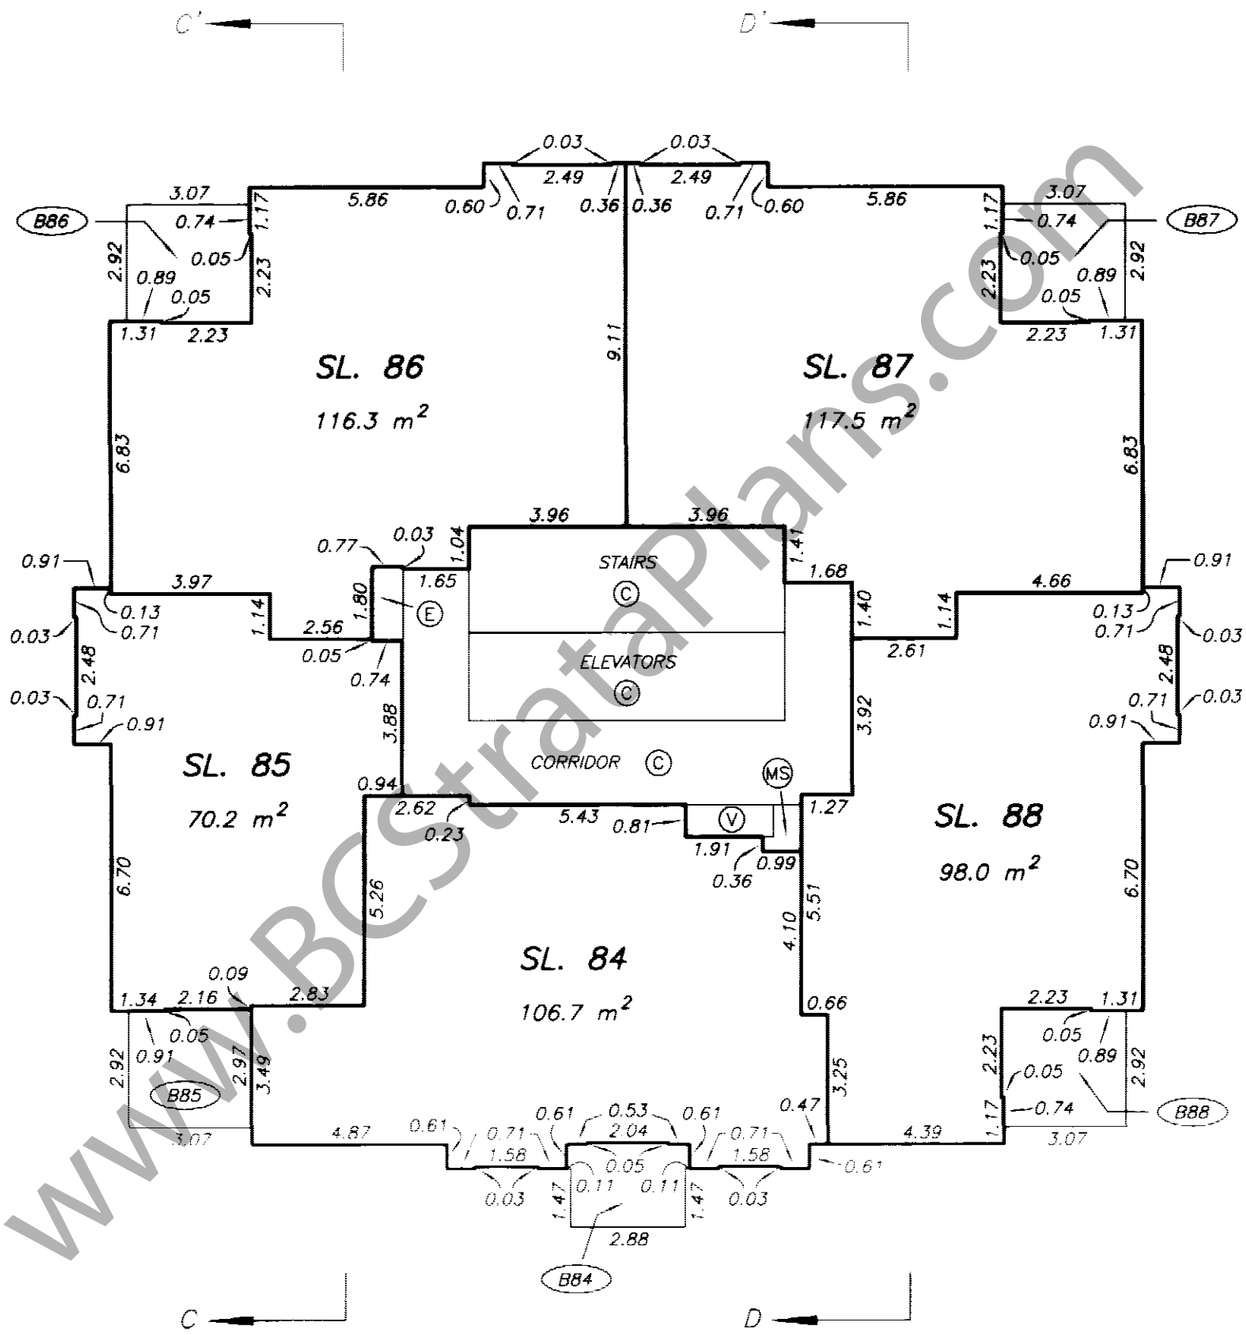

www.BCStrataPlans.com

DRAWING # 30412-20
FILE # 30412-20_T17

DATE : NOVEMBER 25, 2004.

M.E.B.

ORIGINAL

FILED NMBCS1058 T91981 2006-05-17-13.09.44.606497

TOWER LEVEL 18 FLOOR PLAN

STRATA PLAN BCS 1058

SCALE 1:150

2 0 2 4 6

ALL DISTANCES ARE IN METRES.

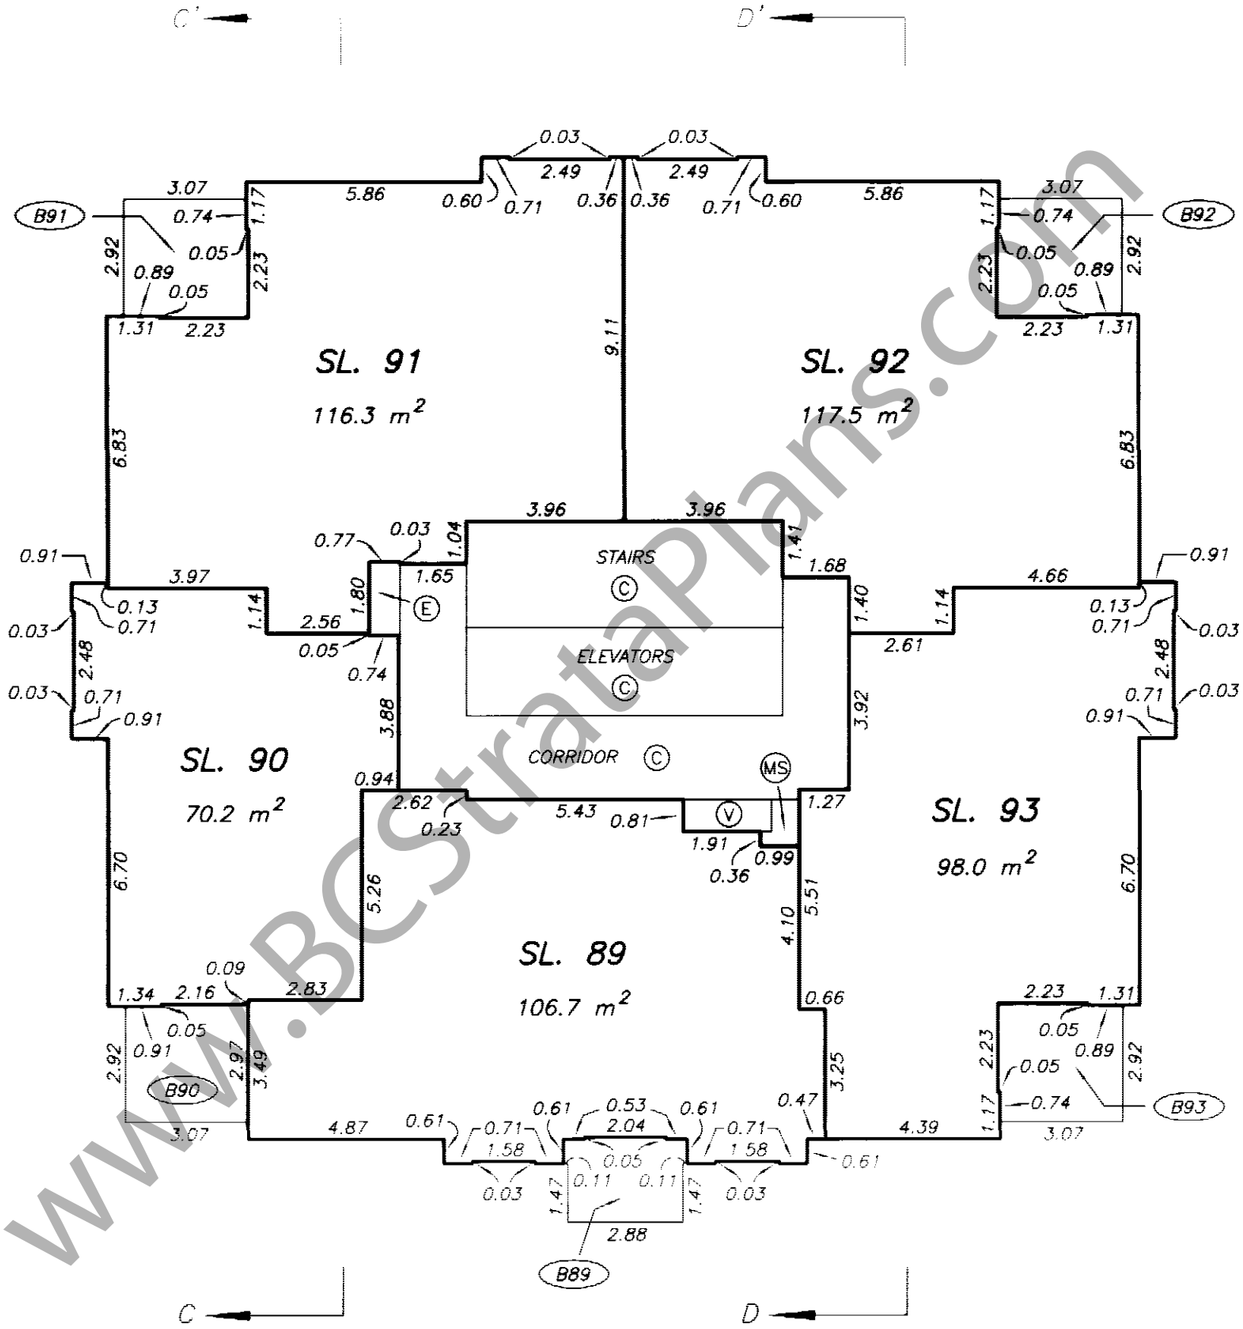

www.BCStrataPlans.com

DRAWING # 30412-20
FILE # 30412-20_T18

DATE : NOVEMBER 25, 2004.

M. C. B.

ORIGINAL

FILED NMBCS1058 T91981 2006-05-17-13.09.44.606497

TOWER LEVEL 19 FLOOR PLAN

STRATA PLAN BCS 1058

SCALE 1:150

2 0 2 4 6

ALL DISTANCES ARE IN METRES.

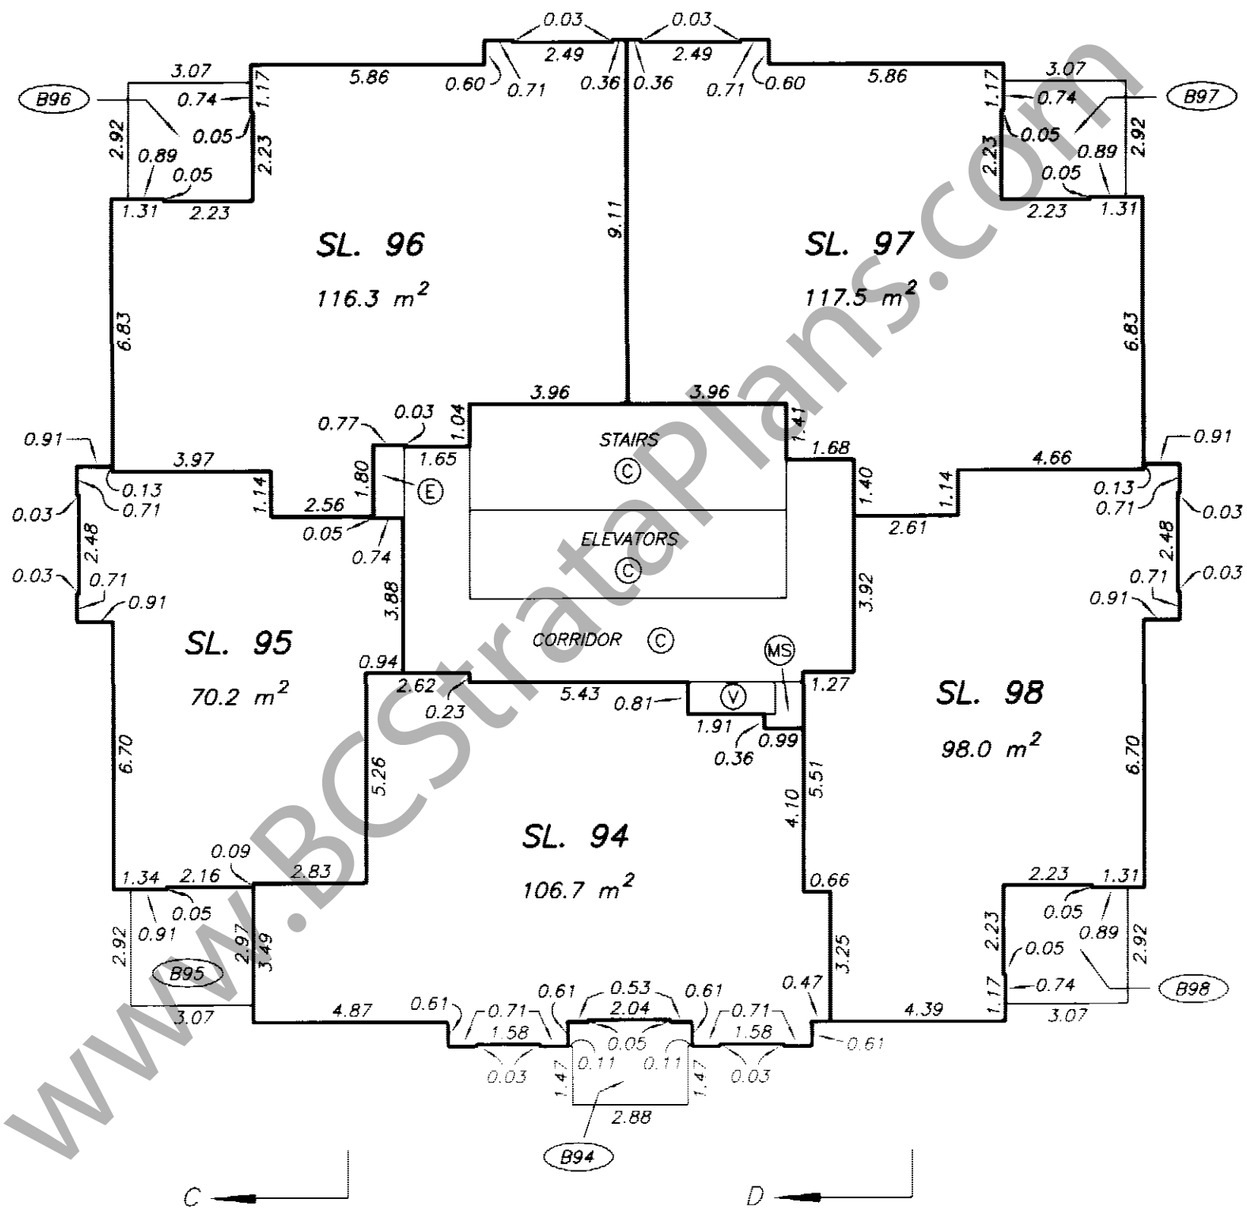

www.BCStrataPlans.com

DRAWING # 30412-20
FILE # 30412-20_T19

DATE : NOVEMBER 25, 2004.

M.E.L.

ORIGINAL

FILED NMBCS1058 T91981 2006-05-17-13.09.44.606497

TOWER LEVEL 20 FLOOR PLAN

STRATA PLAN BCS 1058

SCALE 1:150

2 0 2 4 6

ALL DISTANCES ARE IN METRES.

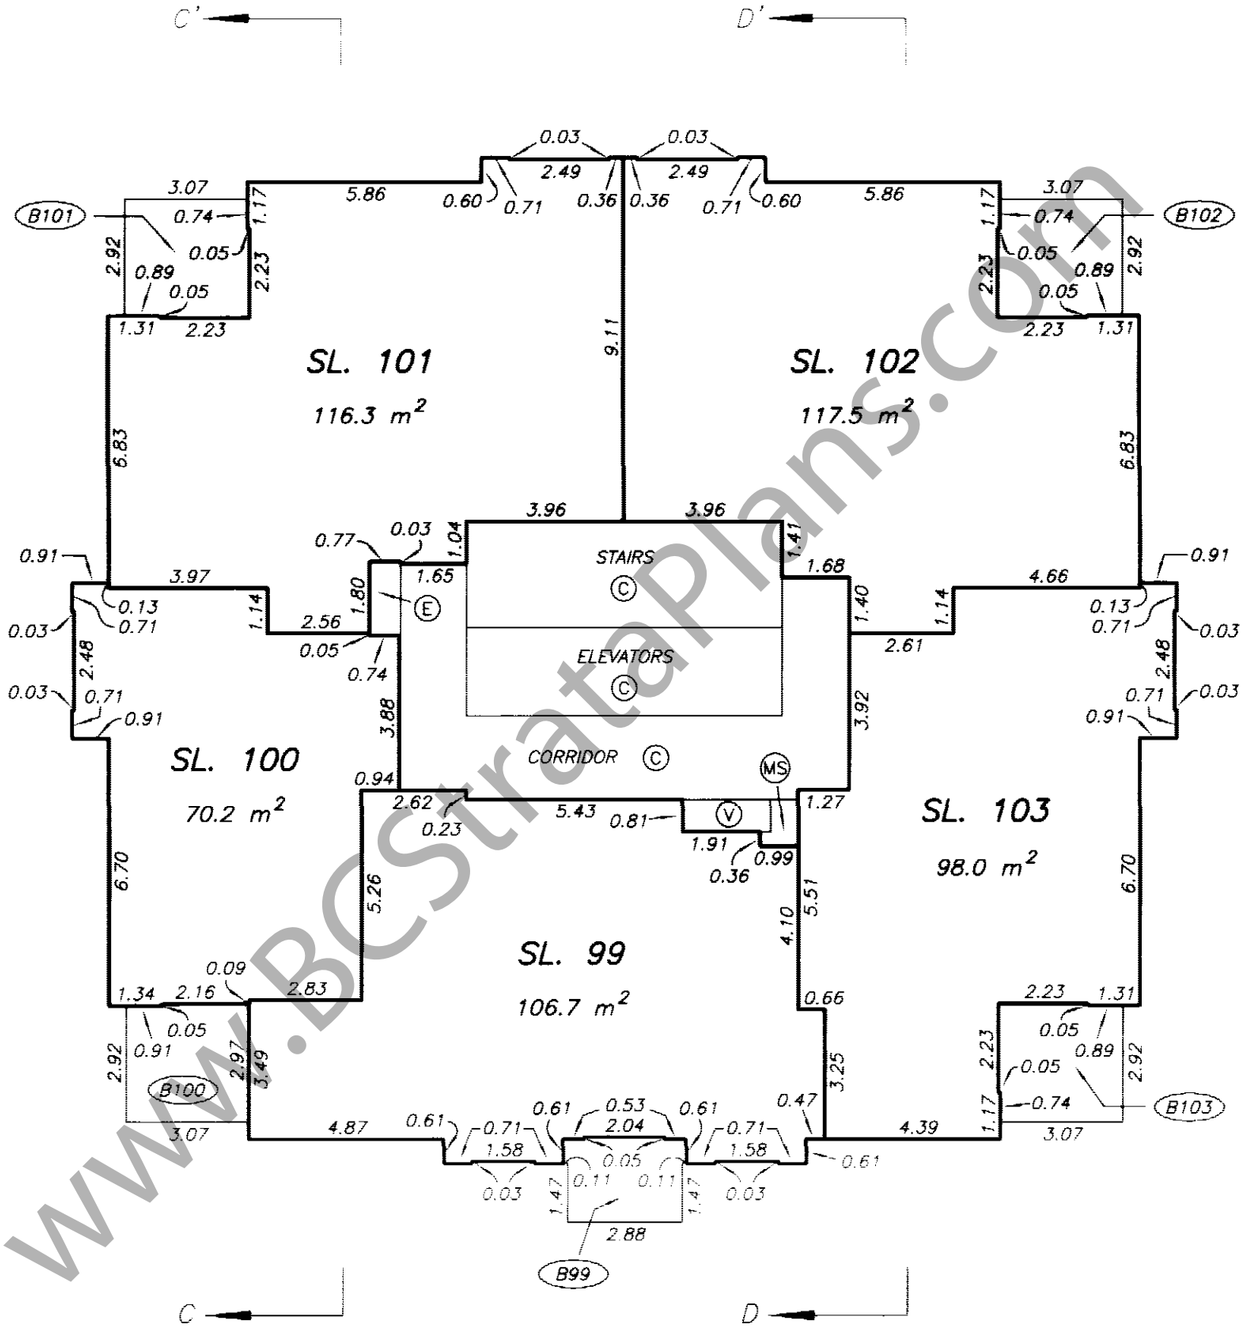

www.BCStrataPlans.com

DRAWING # 30412-20
FILE # 30412-20_T20

DATE : NOVEMBER 25, 2004.

M.E.S.

ORIGINAL

FILED NMBCS1058 T91981 2006-05-17-13.09.44.606497

TOWER LEVEL 21 FLOOR PLAN

STRATA PLAN BCS 1058

SCALE 1:150

2 0 2 4 6

ALL DISTANCES ARE IN METRES.

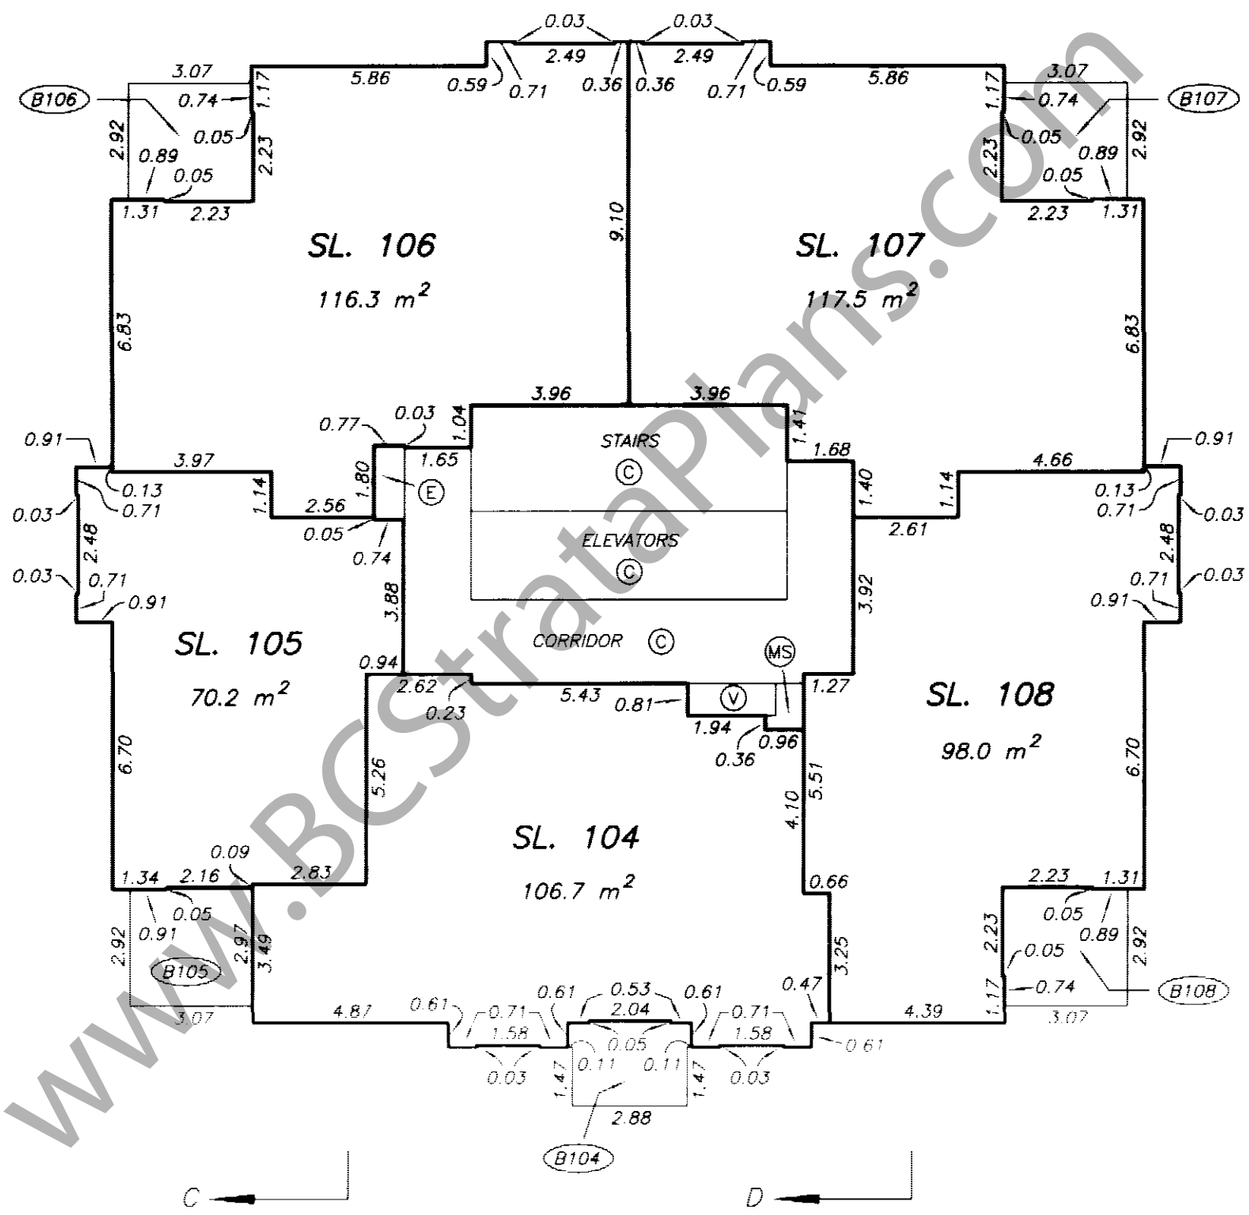

www.BCStrataPlans.com

DRAWING # 30412-20
FILE # 30412-20_T21

DATE : NOVEMBER 25, 2004.

M. E. de.

ORIGINAL

FILED NMBCS1058 T91981 2006-05-17-13.09.44.606497

TOWER LEVEL 22 FLOOR PLAN

STRATA PLAN BCS 1058

SCALE 1:150

2 0 2 4 6

ALL DISTANCES ARE IN METRES.

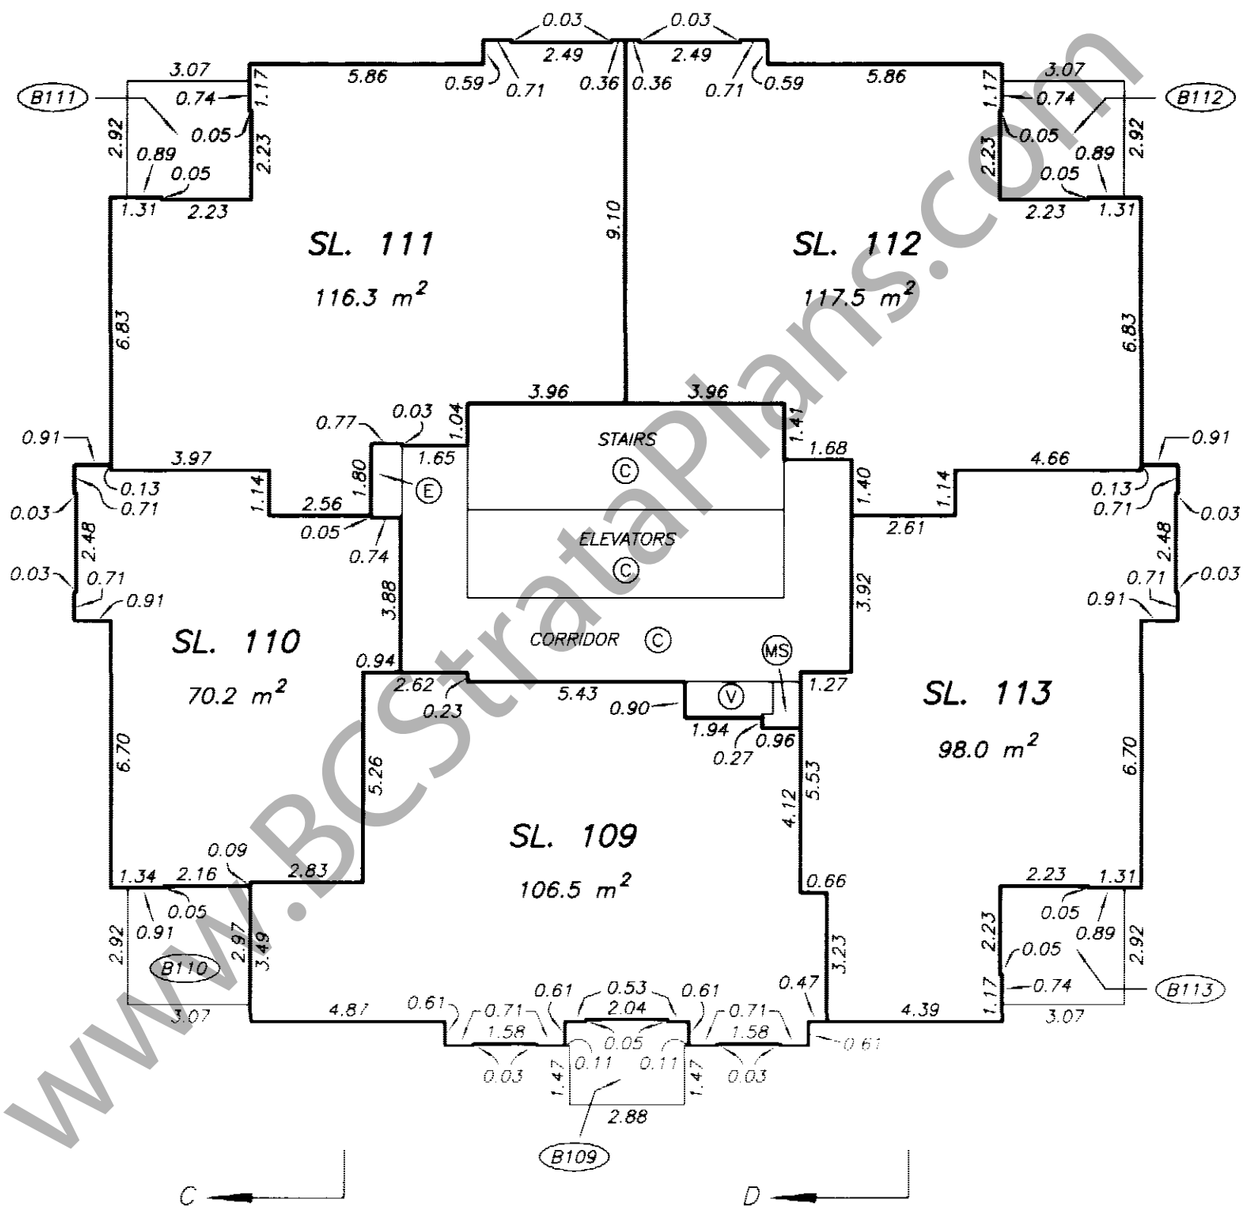

www.BCStrataPlans.com

DRAWING # 30412-20
FILE # 30412-20_T22

DATE : NOVEMBER 25, 2004.

M.C.S.

ORIGINAL

FILED NWBCS1058 T91981 2006-05-17-13.09.44.606497

TOWER LEVEL 23 FLOOR PLAN

STRATA PLAN BCS 1058

SCALE 1:150

2 0 2 4 6

ALL DISTANCES ARE IN METRES.

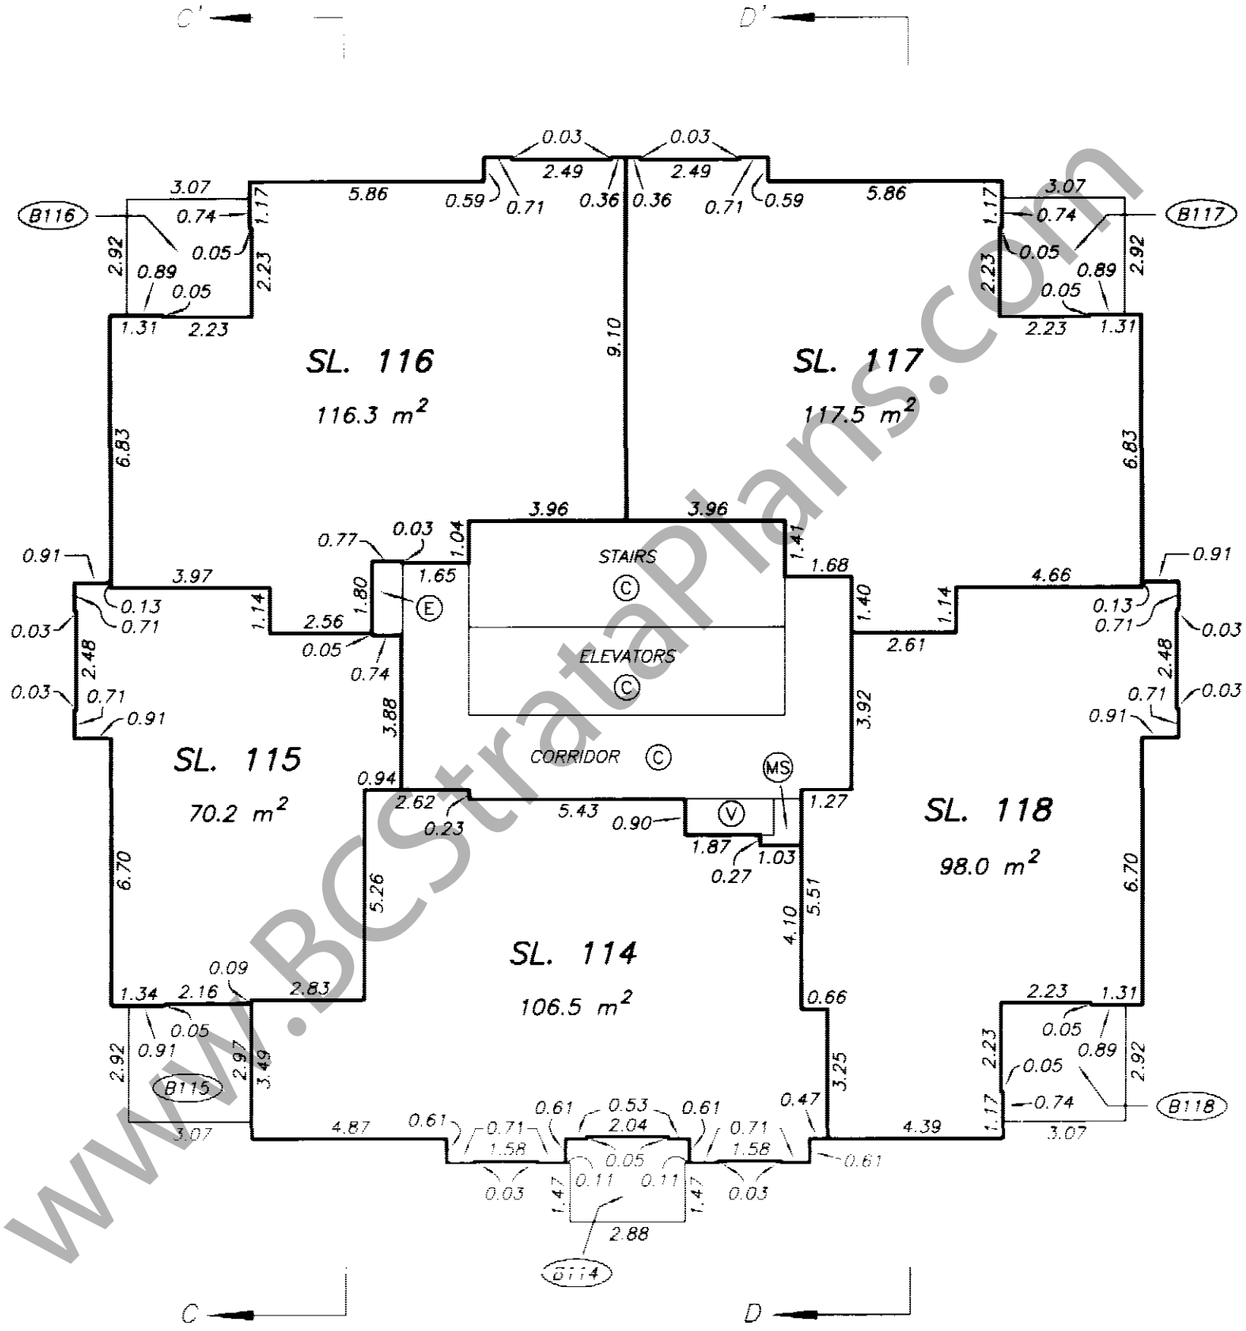

www.BCStrataPlans.com

DRAWING # 30412-20
FILE # 30412-20_T23

DATE : NOVEMBER 25, 2004.

M.E.S.

ORIGINAL

FILED NMBCS1058 T91981 2006-05-17-13.09.44.606497

TOWER LEVEL 24 FLOOR PLAN

STRATA PLAN BCS 1058

SCALE 1:150

2 0 2 4 6

ALL DISTANCES ARE IN METRES.

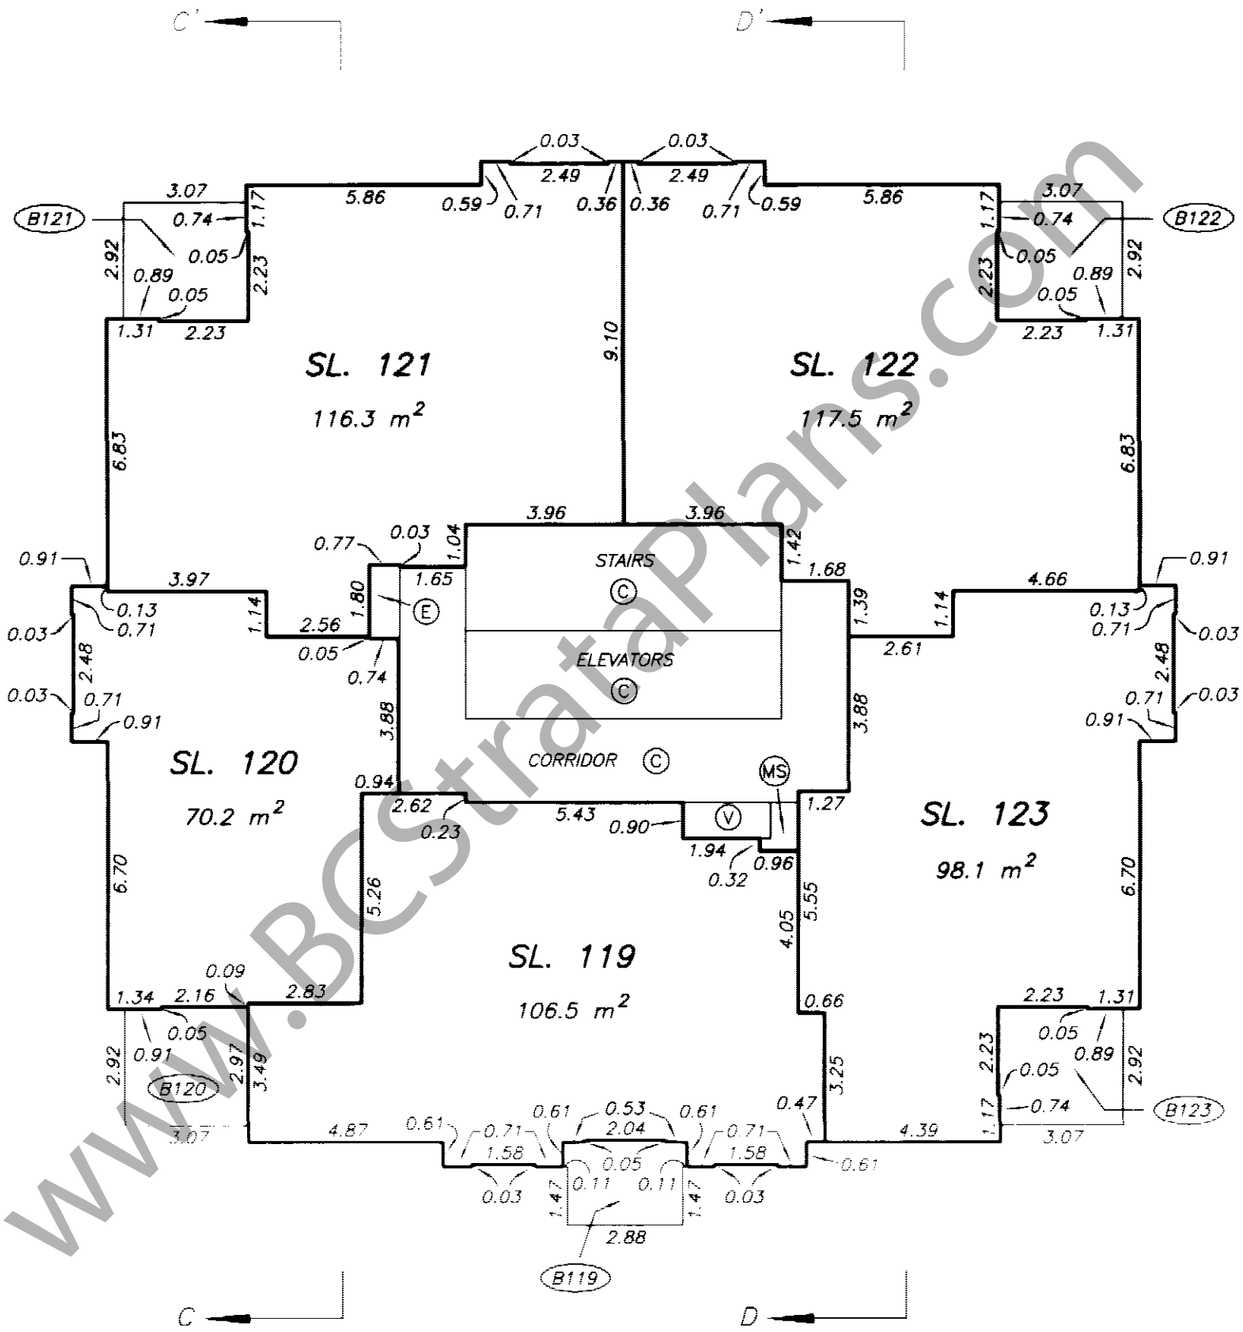

www.BCStrataPlans.com

DRAWING # 30412-20
FILE # 30412-20_T24

DATE : NOVEMBER 25, 2004.

M. E. S.

ORIGINAL

FILED NMBCS1058 T91981 2006-05-17-13.09.44.606497

TOWER LEVEL 25 FLOOR PLAN

STRATA PLAN BCS 1058

SCALE 1:150

2 0 2 4 6

ALL DISTANCES ARE IN METRES.

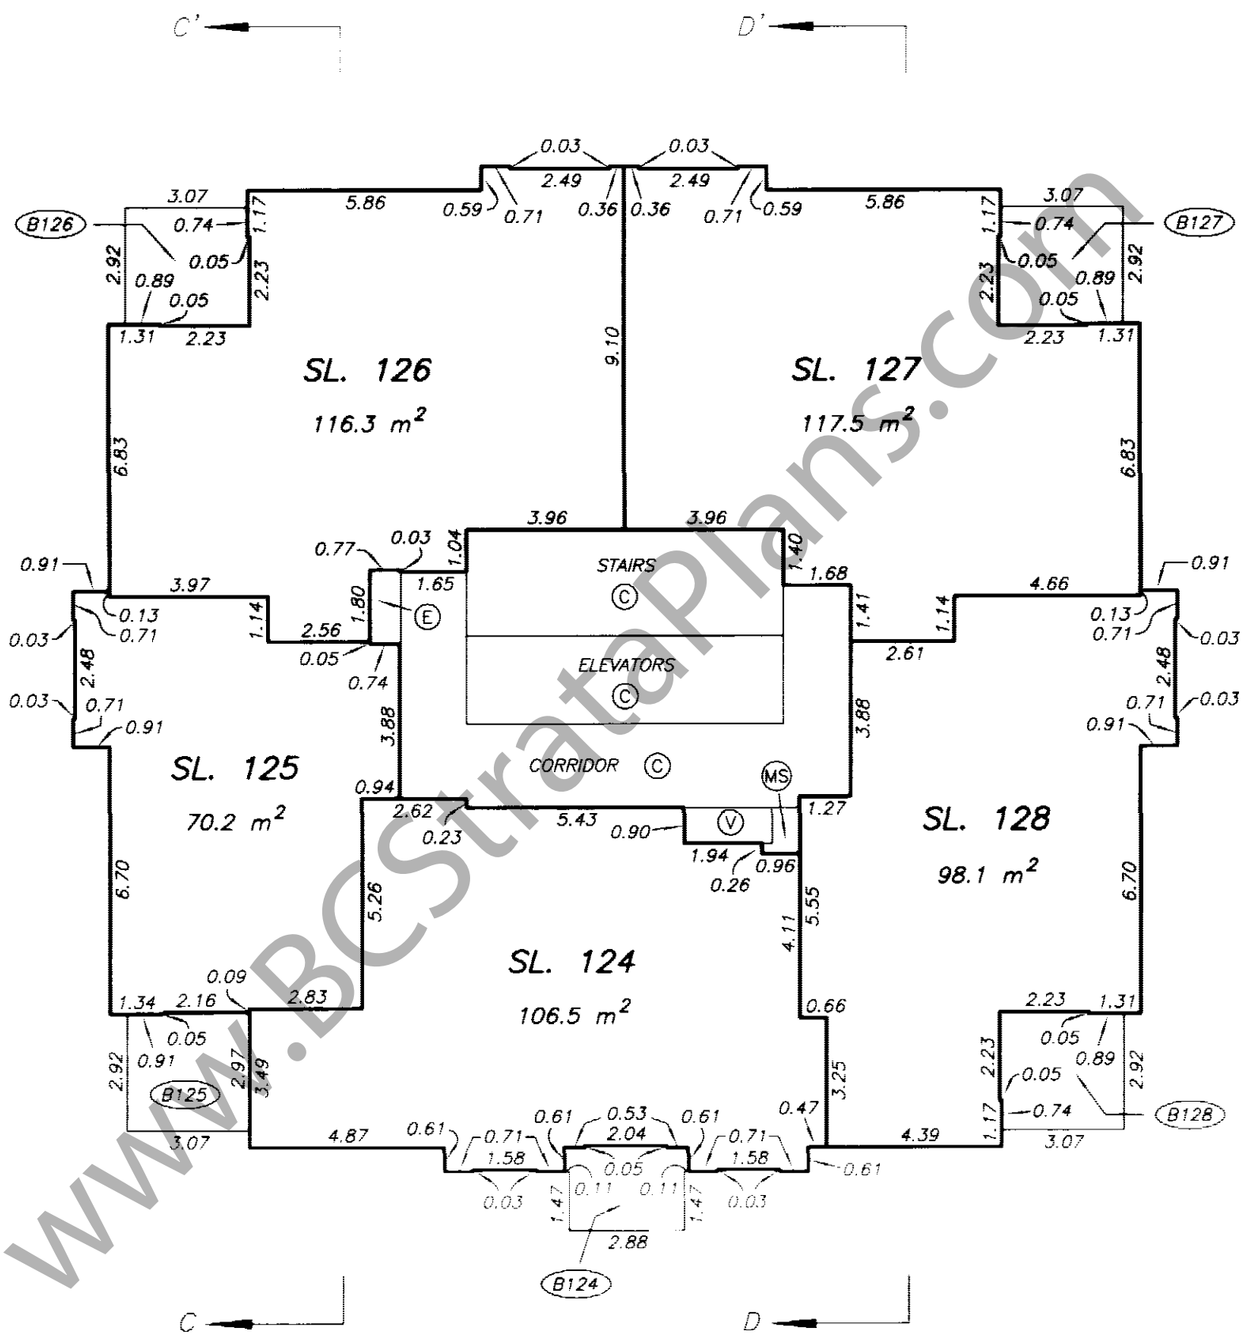

www.BCStrataPlans.com

DRAWING # 30412-20
FILE # 30412-20_T25

DATE : NOVEMBER 25, 2004.

M.E.S.

ORIGINAL

FILED NMBCS1058 T91981 2006-05-17-13.09.44.606497

TOWER LEVEL 26 FLOOR PLAN

STRATA PLAN BCS 1058

SCALE 1:150

2 0 2 4 6

ALL DISTANCES ARE IN METRES.

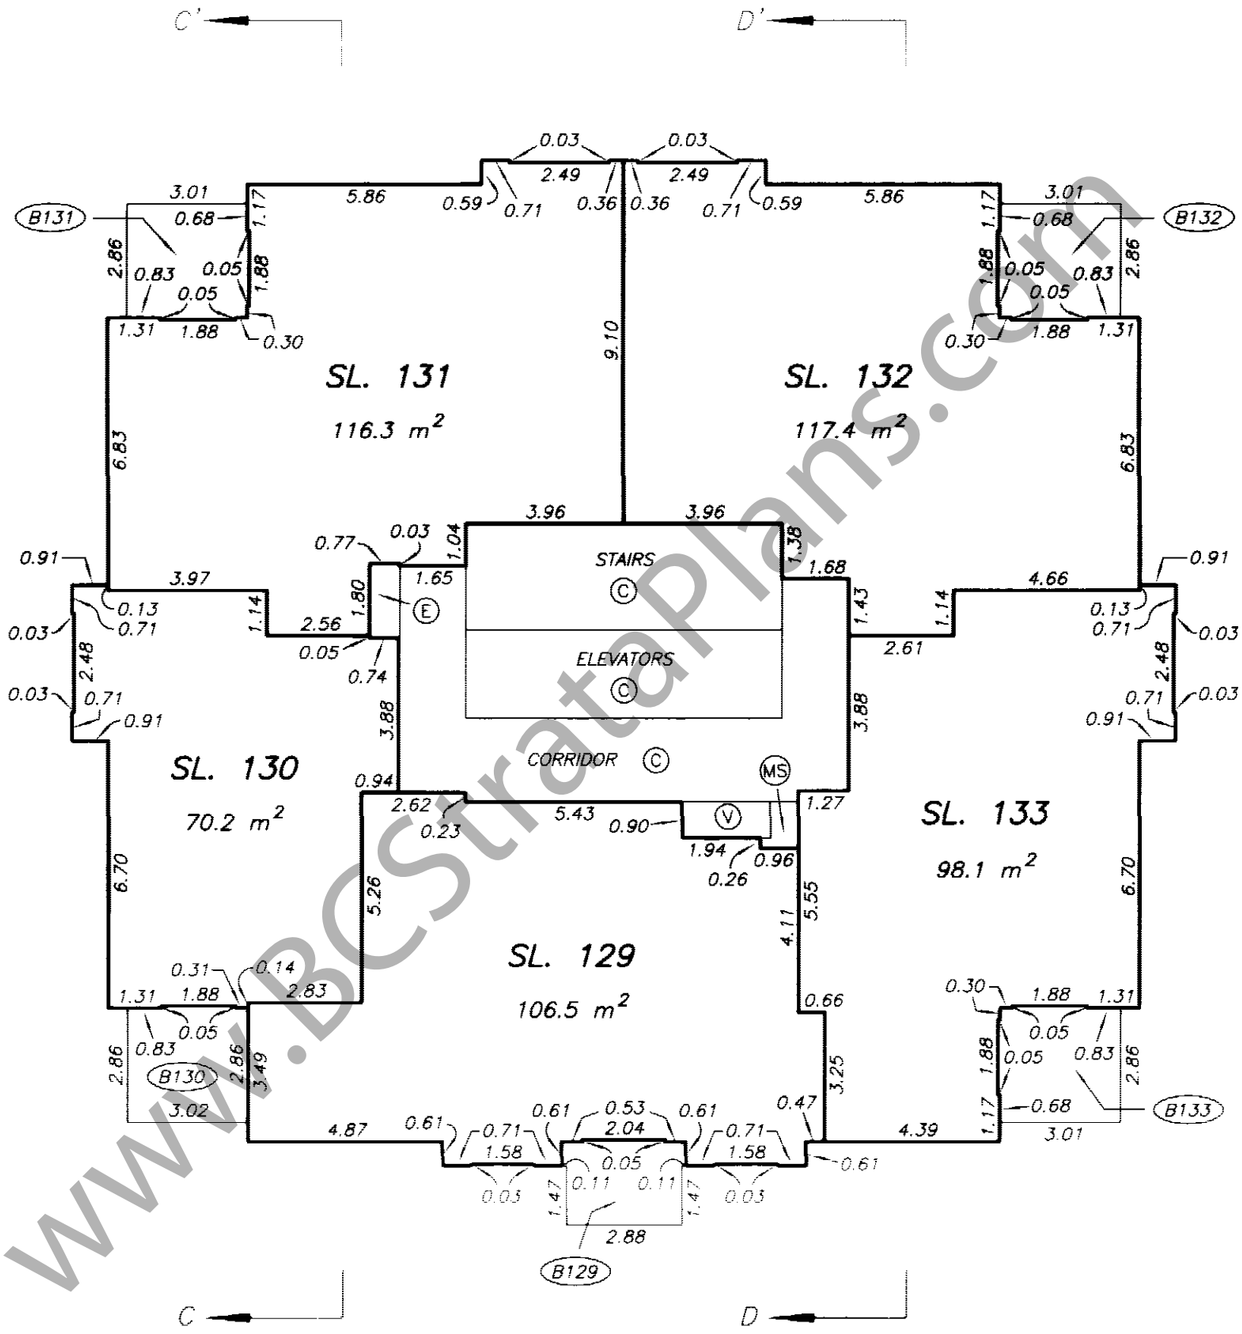

www.BCStrataPlans.com

DRAWING # 30412-20
FILE # 30412-20_T26

DATE : NOVEMBER 25, 2004.

M.E.L.

ORIGINAL

FILED NMBCS1058 T91981 2006-05-17-13.09.44.606497

TOWER LEVEL 27 FLOOR PLAN

STRATA PLAN BCS 1058

SCALE 1:150

2 0 2 4 6

ALL DISTANCES ARE IN METRES.

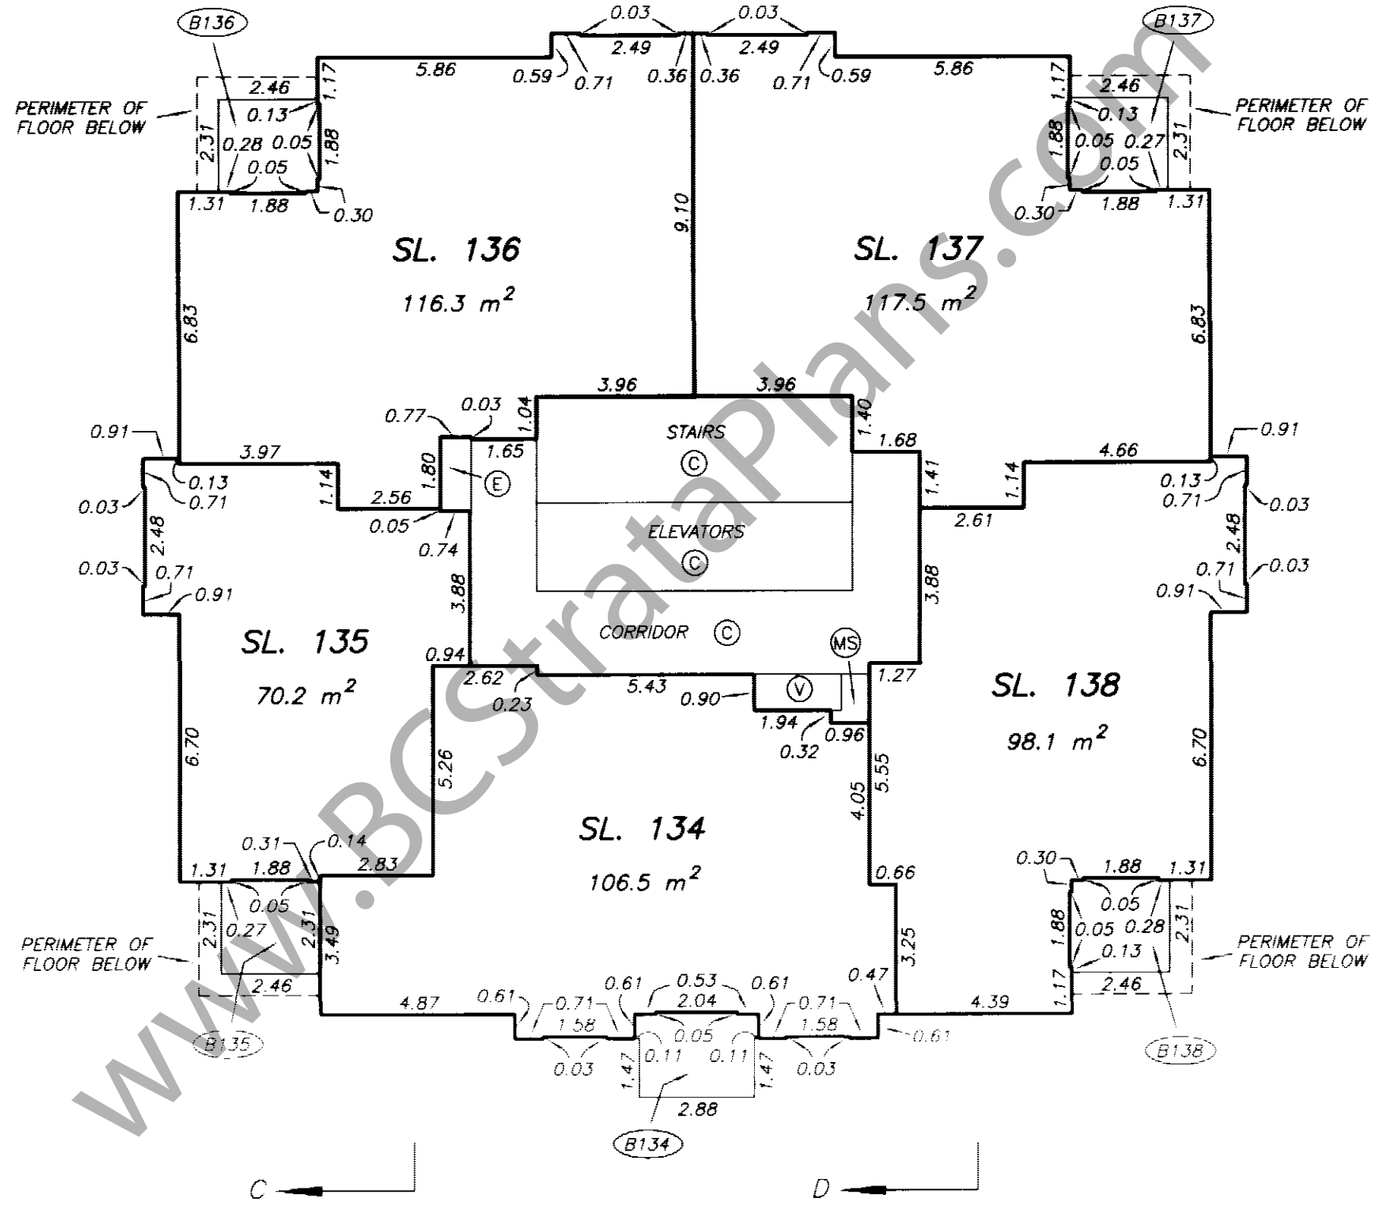

www.BCStrataPlans.com

DRAWING # 30412-20
FILE # 30412-20_T27

DATE : NOVEMBER 25, 2004.

M.E.B.

ORIGINAL

FILED NMBCS1058 T91981 2006-05-17-13.09.44.606497

TOWER LEVEL 28 FLOOR PLAN

STRATA PLAN BCS 1058

SCALE 1:150

2 0 2 4 6

ALL DISTANCES ARE IN METRES.

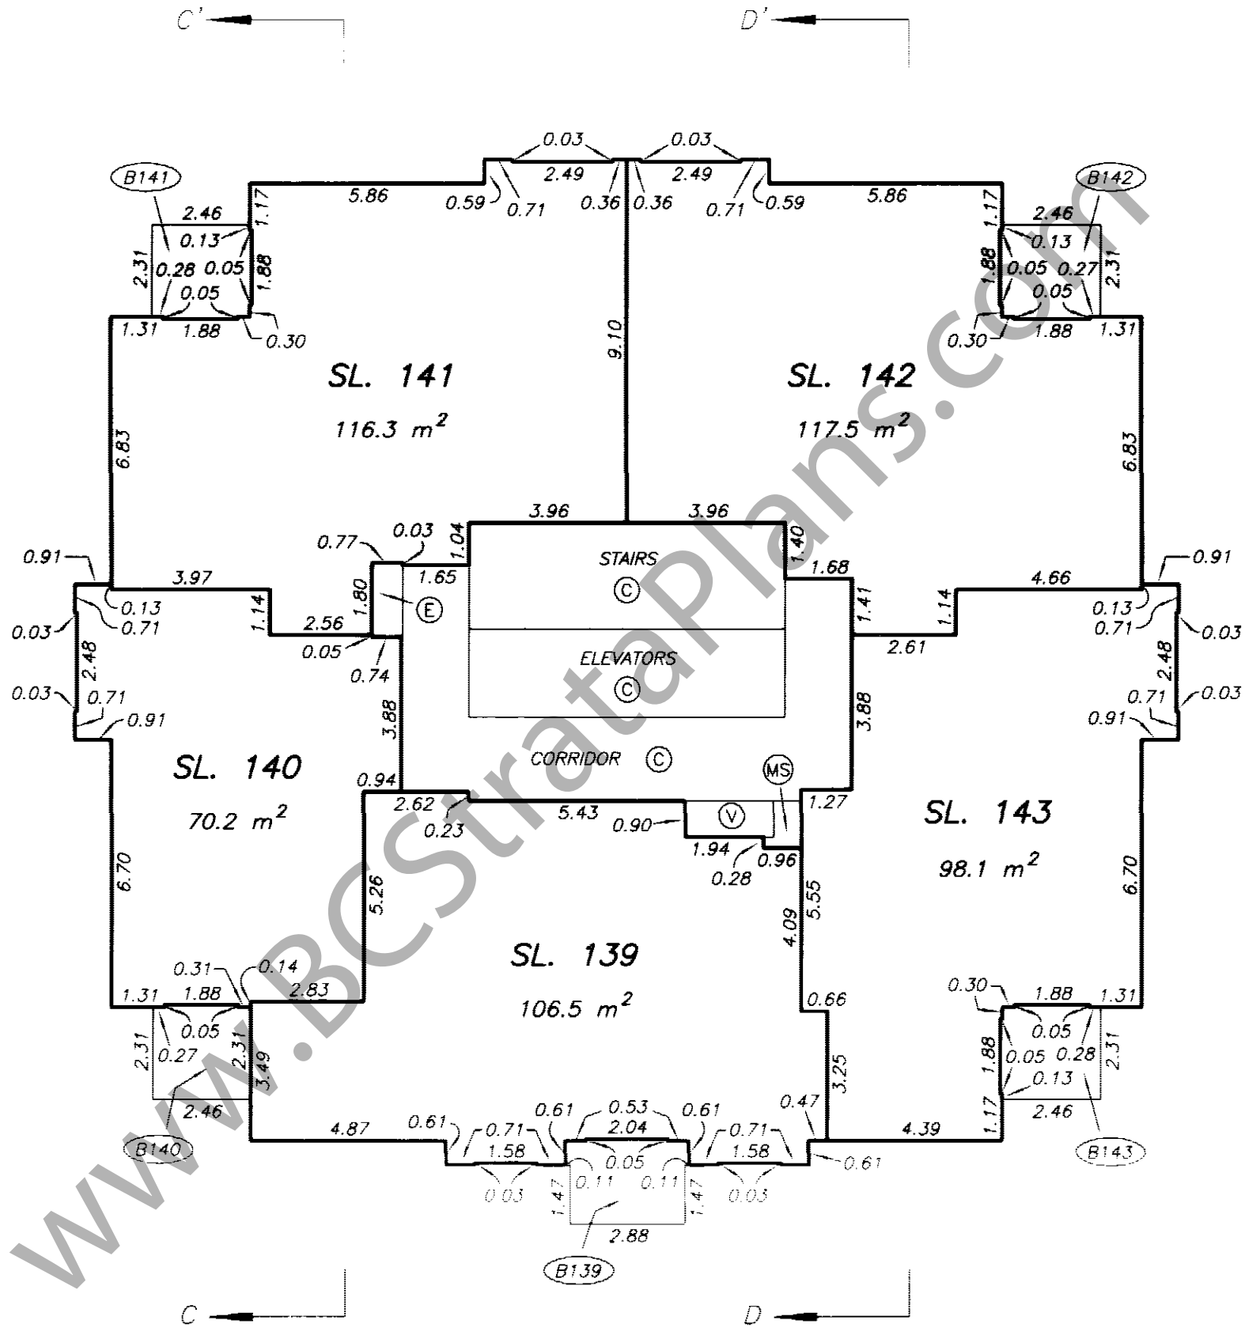

www.BCStrataPlans.com

DRAWING # 30412-20
FILE # 30412-20_T28

DATE : NOVEMBER 25, 2004.

ORIGINAL

FILED NMBCS1058 T91981 2006-05-17-13.09.44.606497

TOWER LEVEL 29 FLOOR PLAN

STRATA PLAN BCS 1058

SCALE 1:150

2 0 2 4 6

ALL DISTANCES ARE IN METRES.

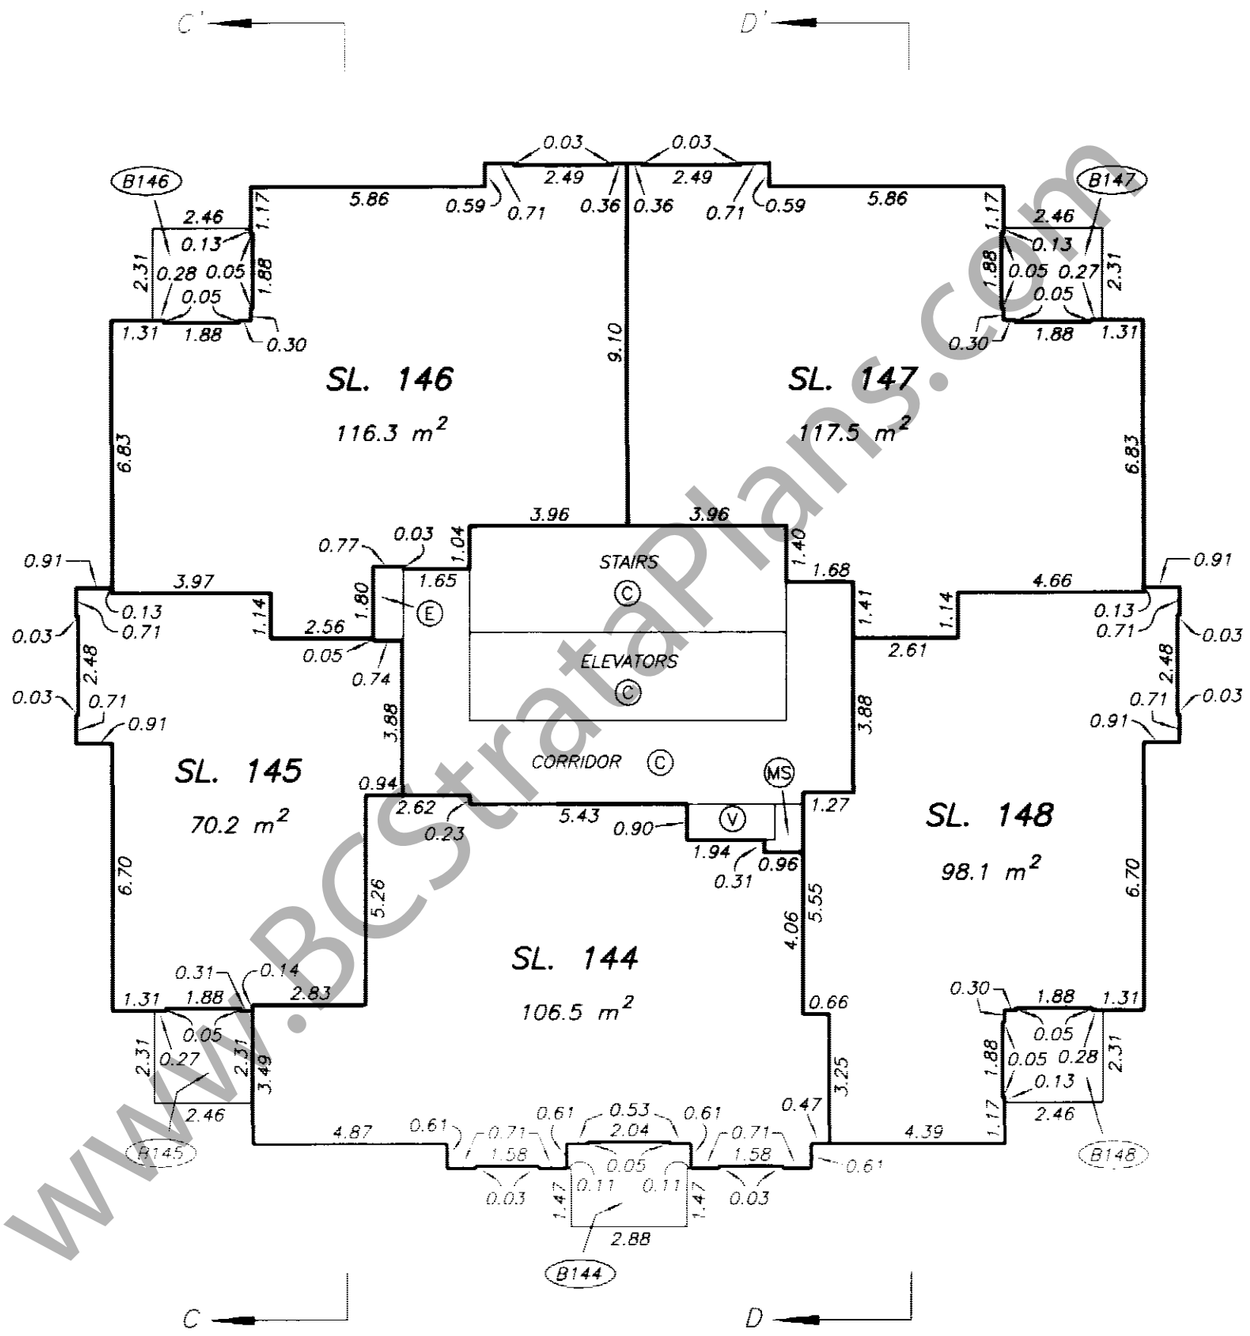

www.BCStrataPlans.com

DRAWING # 30412-20
FILE # 30412-20_T29

DATE : NOVEMBER 25, 2004.

M.E.B.

ORIGINAL

FILED NWBCS1058 T91981 2006-05-17-13.09.44.606497

TOWER LEVEL 30 FLOOR PLAN

STRATA PLAN BCS 1058

SCALE 1:150

2 0 2 4 6

ALL DISTANCES ARE IN METRES.

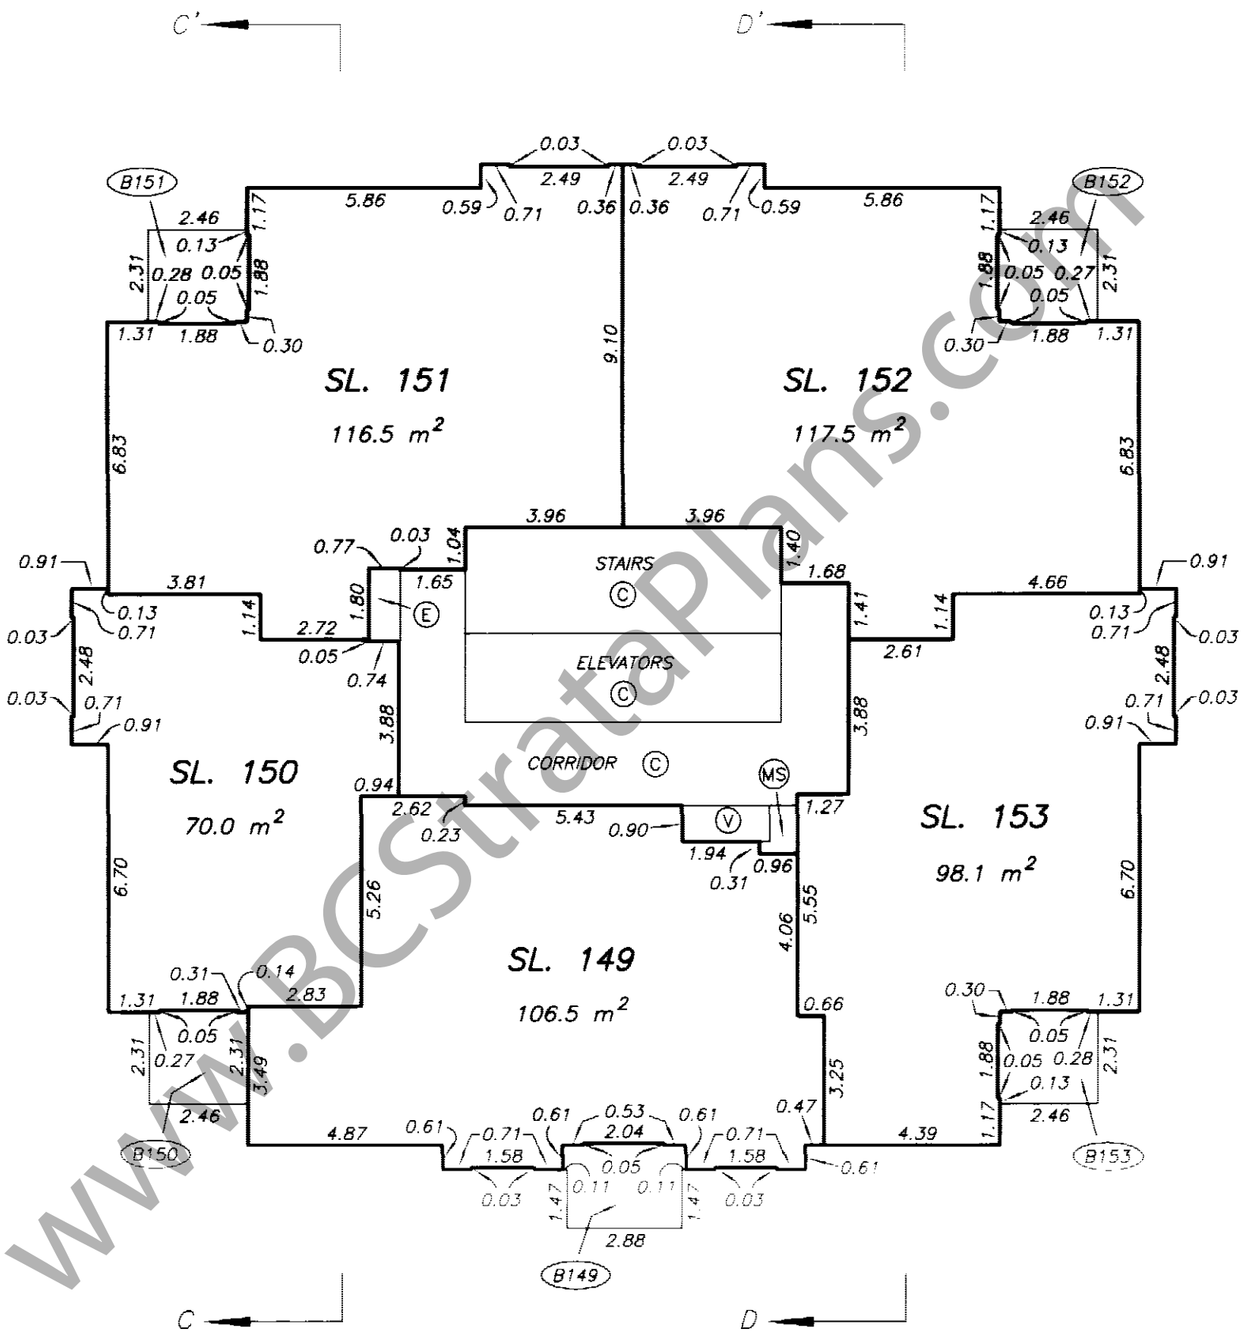

www.BCStrataPlans.com

DRAWING # 30412-20
FILE # 30412-20_T30

DATE : NOVEMBER 25, 2004.

M.C.B.

ORIGINAL

FILED NMBCS1058 T91981 2006-05-17-13.09.44.606497

TOWER LEVEL 31 FLOOR PLAN

STRATA PLAN BCS 1058

SCALE 1:150

2 0 2 4 6

ALL DISTANCES ARE IN METRES.

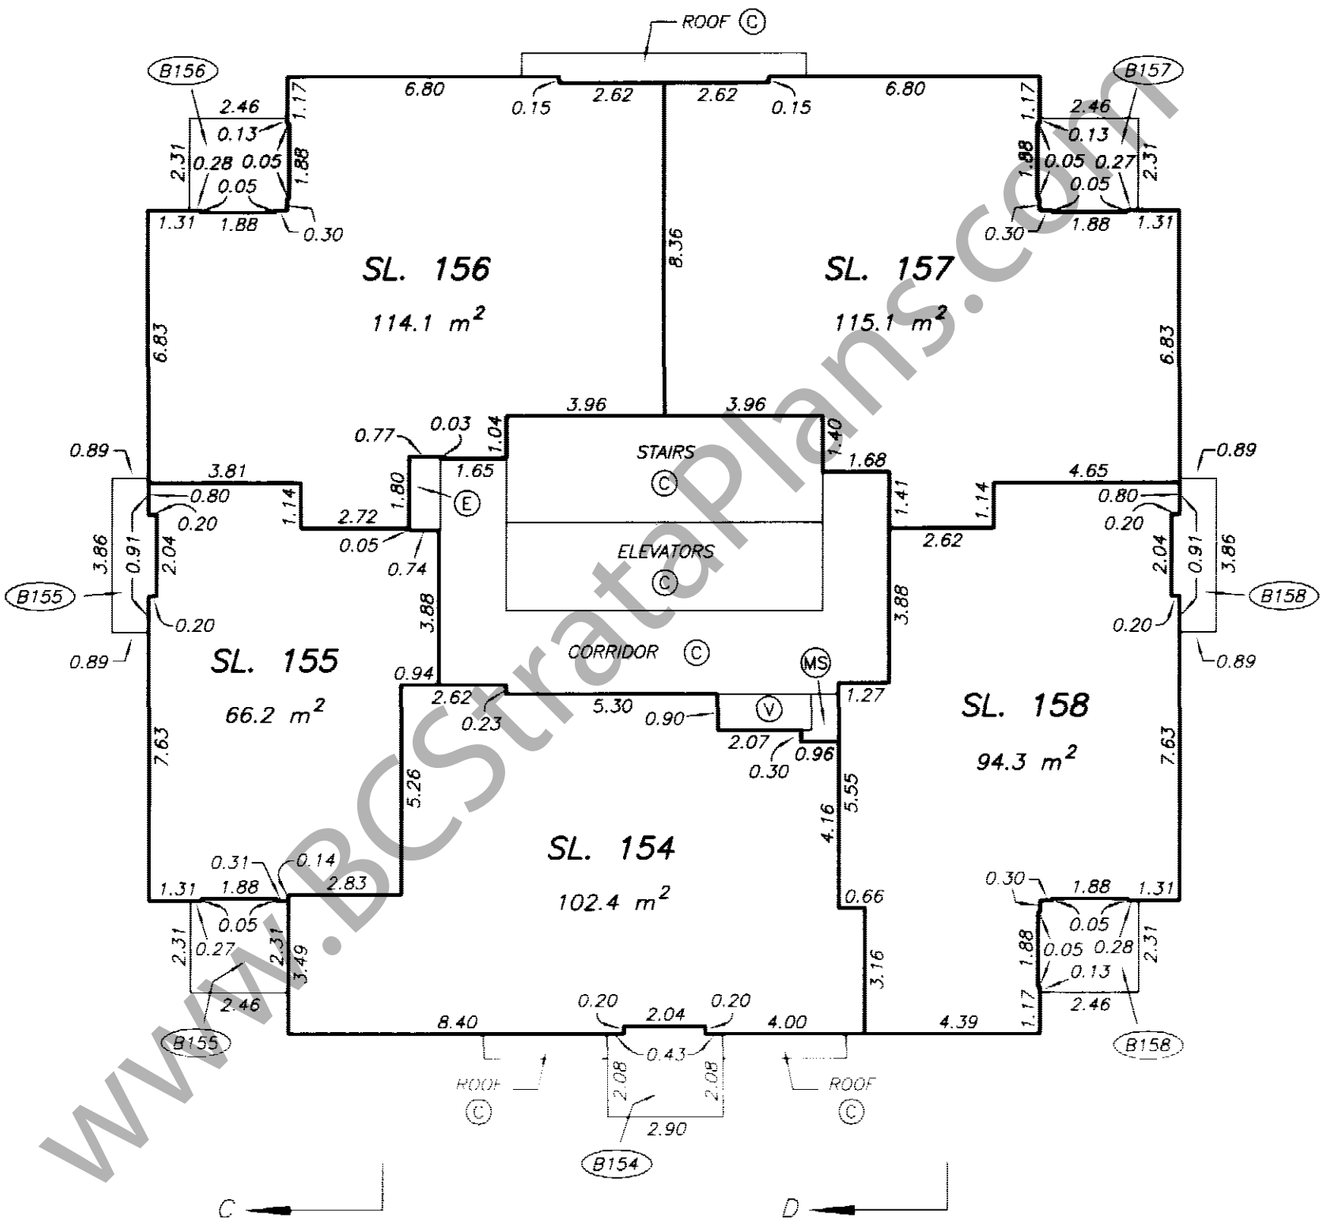

www.BCStrataPlans.com

DRAWING # 30412-20
FILE # 30412-20_T31

DATE : NOVEMBER 25, 2004.

M.E.B.

ORIGINAL

FILED NMBCS1058 T91981 2006-05-17-13.09.44.606497

TOWER LEVEL 32 FLOOR PLAN

STRATA PLAN BCS 1058

SCALE 1:150

2 0 2 4 6

ALL DISTANCES ARE IN METRES.

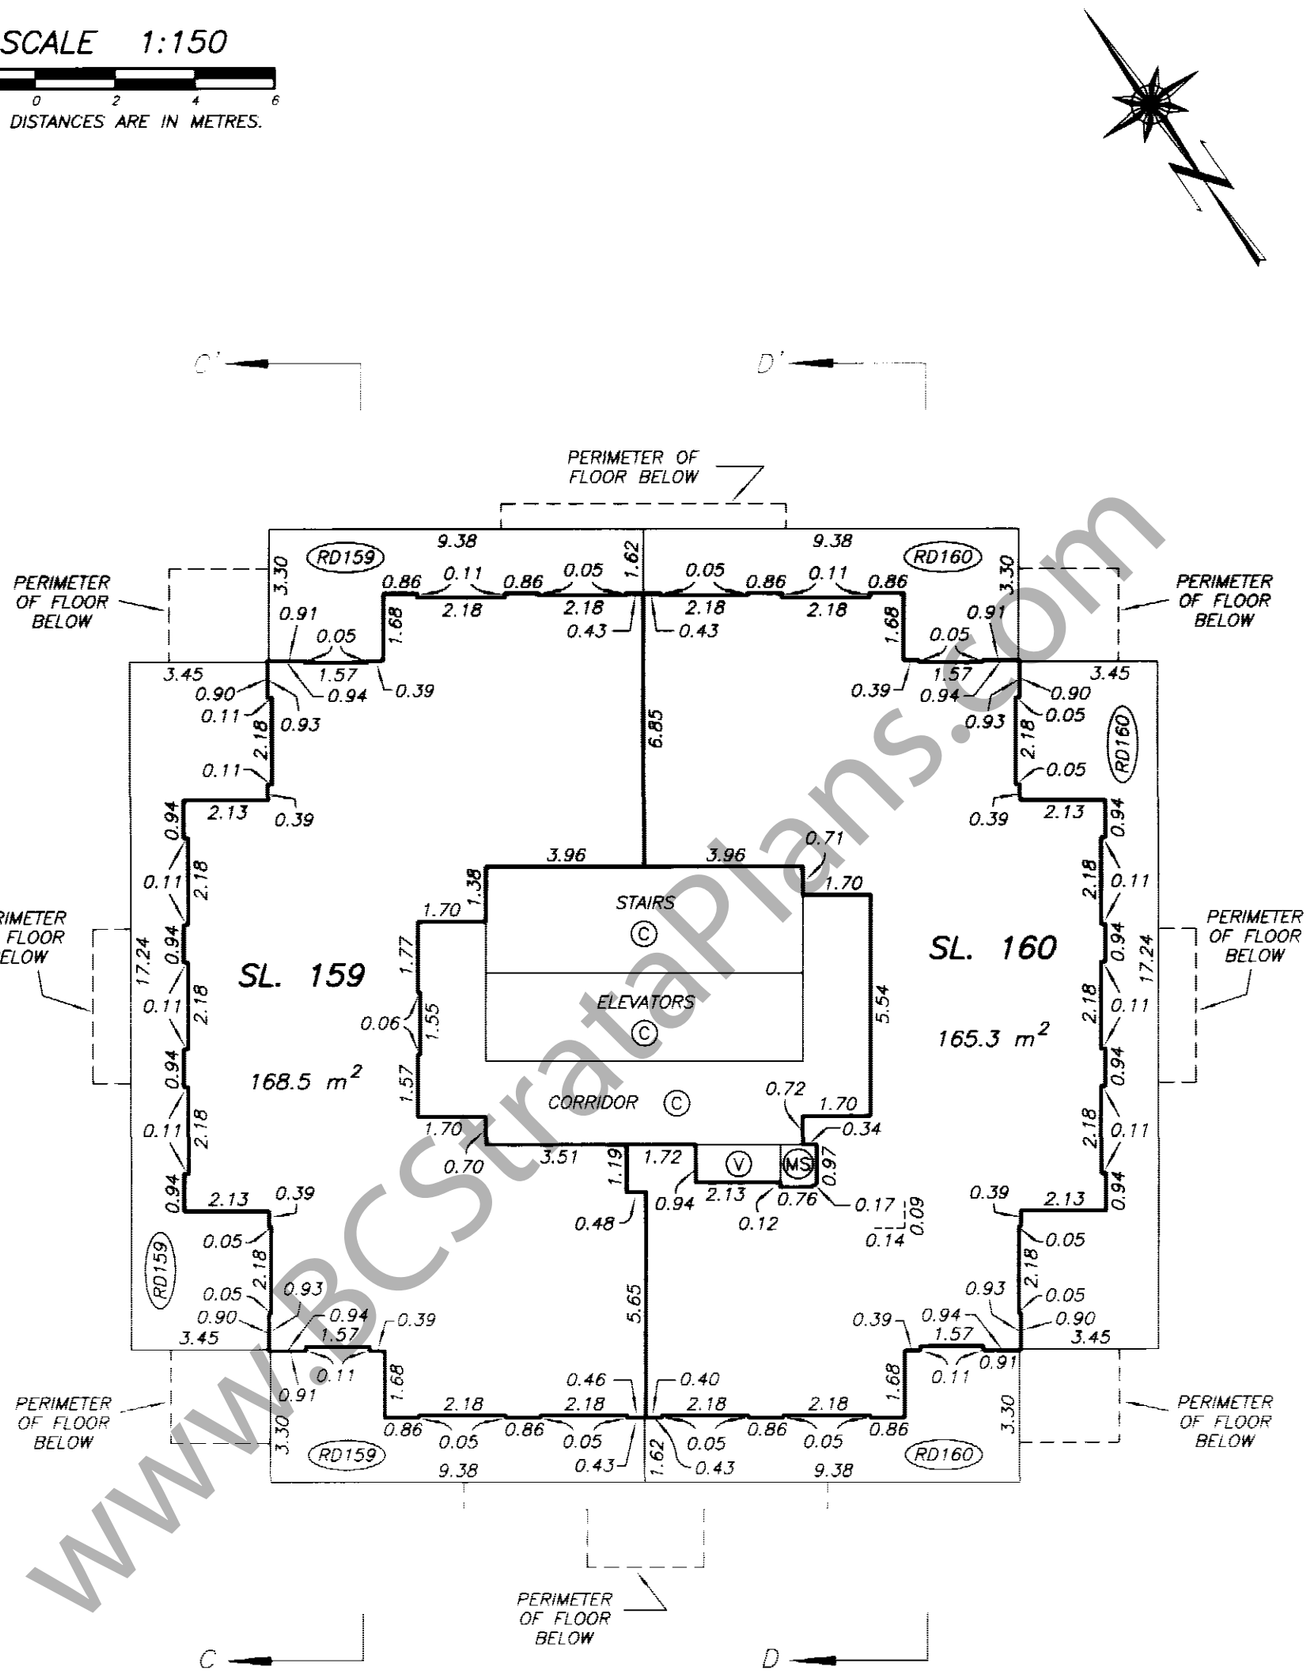

www.BCStrataPlans.com

DRAWING # 30412-20
FILE # 30412-20_T32

DATE : NOVEMBER 25, 2004.

M.E.B.

ORIGINAL

FILED NWBCS1058 T91981 2006-05-17-13.09.44.606497

TOWER MECHANICAL LEVEL FLOOR PLAN

STRATA PLAN BCS 1058

SCALE 1:150

2 0 2 4 6

ALL DISTANCES ARE IN METRES.

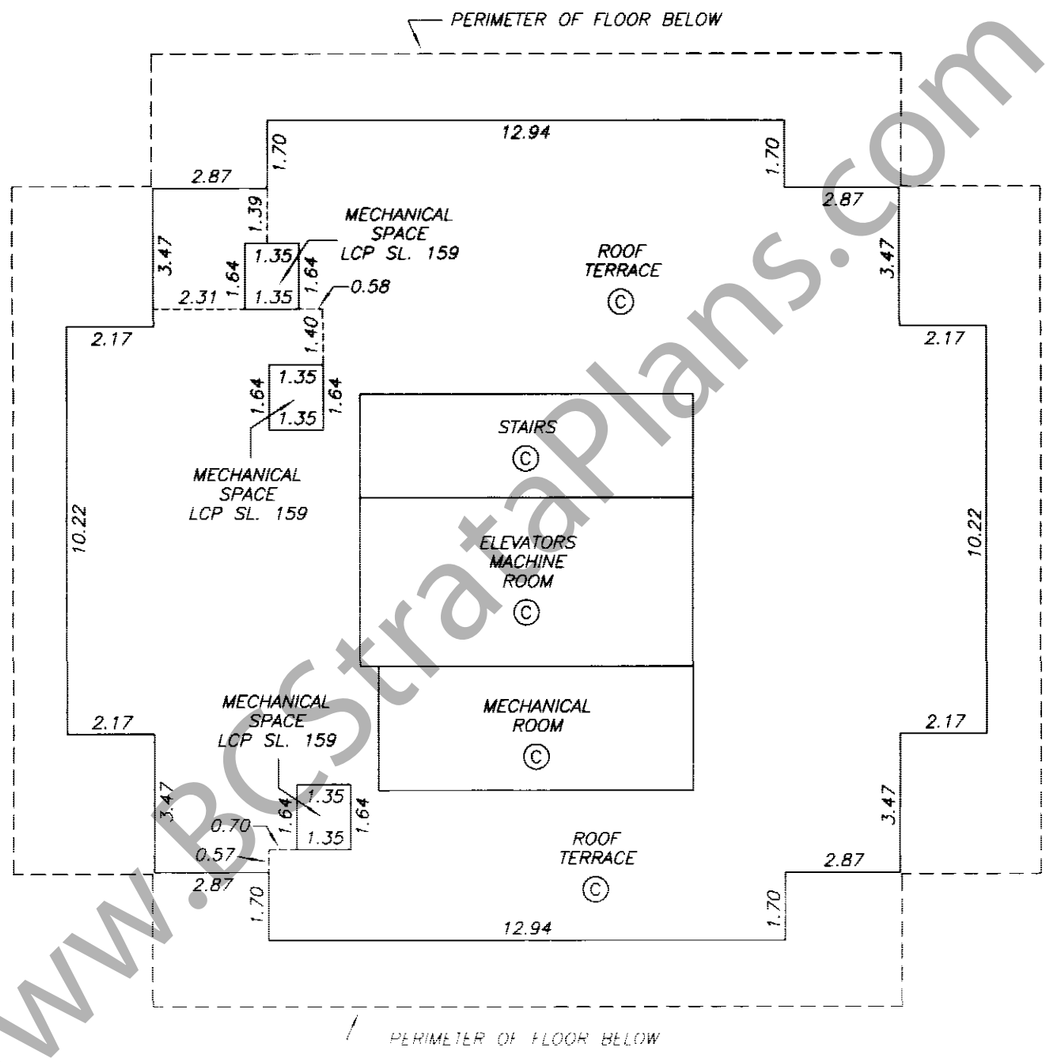

www.BCStrataPlans.com

DATE : NOVEMBER 25, 2004.

M.E.B.

DRAWING # 30412-20
FILE # 30412-20_T32

ORIGINAL

FILED NWBCS1058 T91981 2006-05-17-13.09.44.606497